

Question 8g Form B6


2923-07

338829m  
196431m

389

390

391

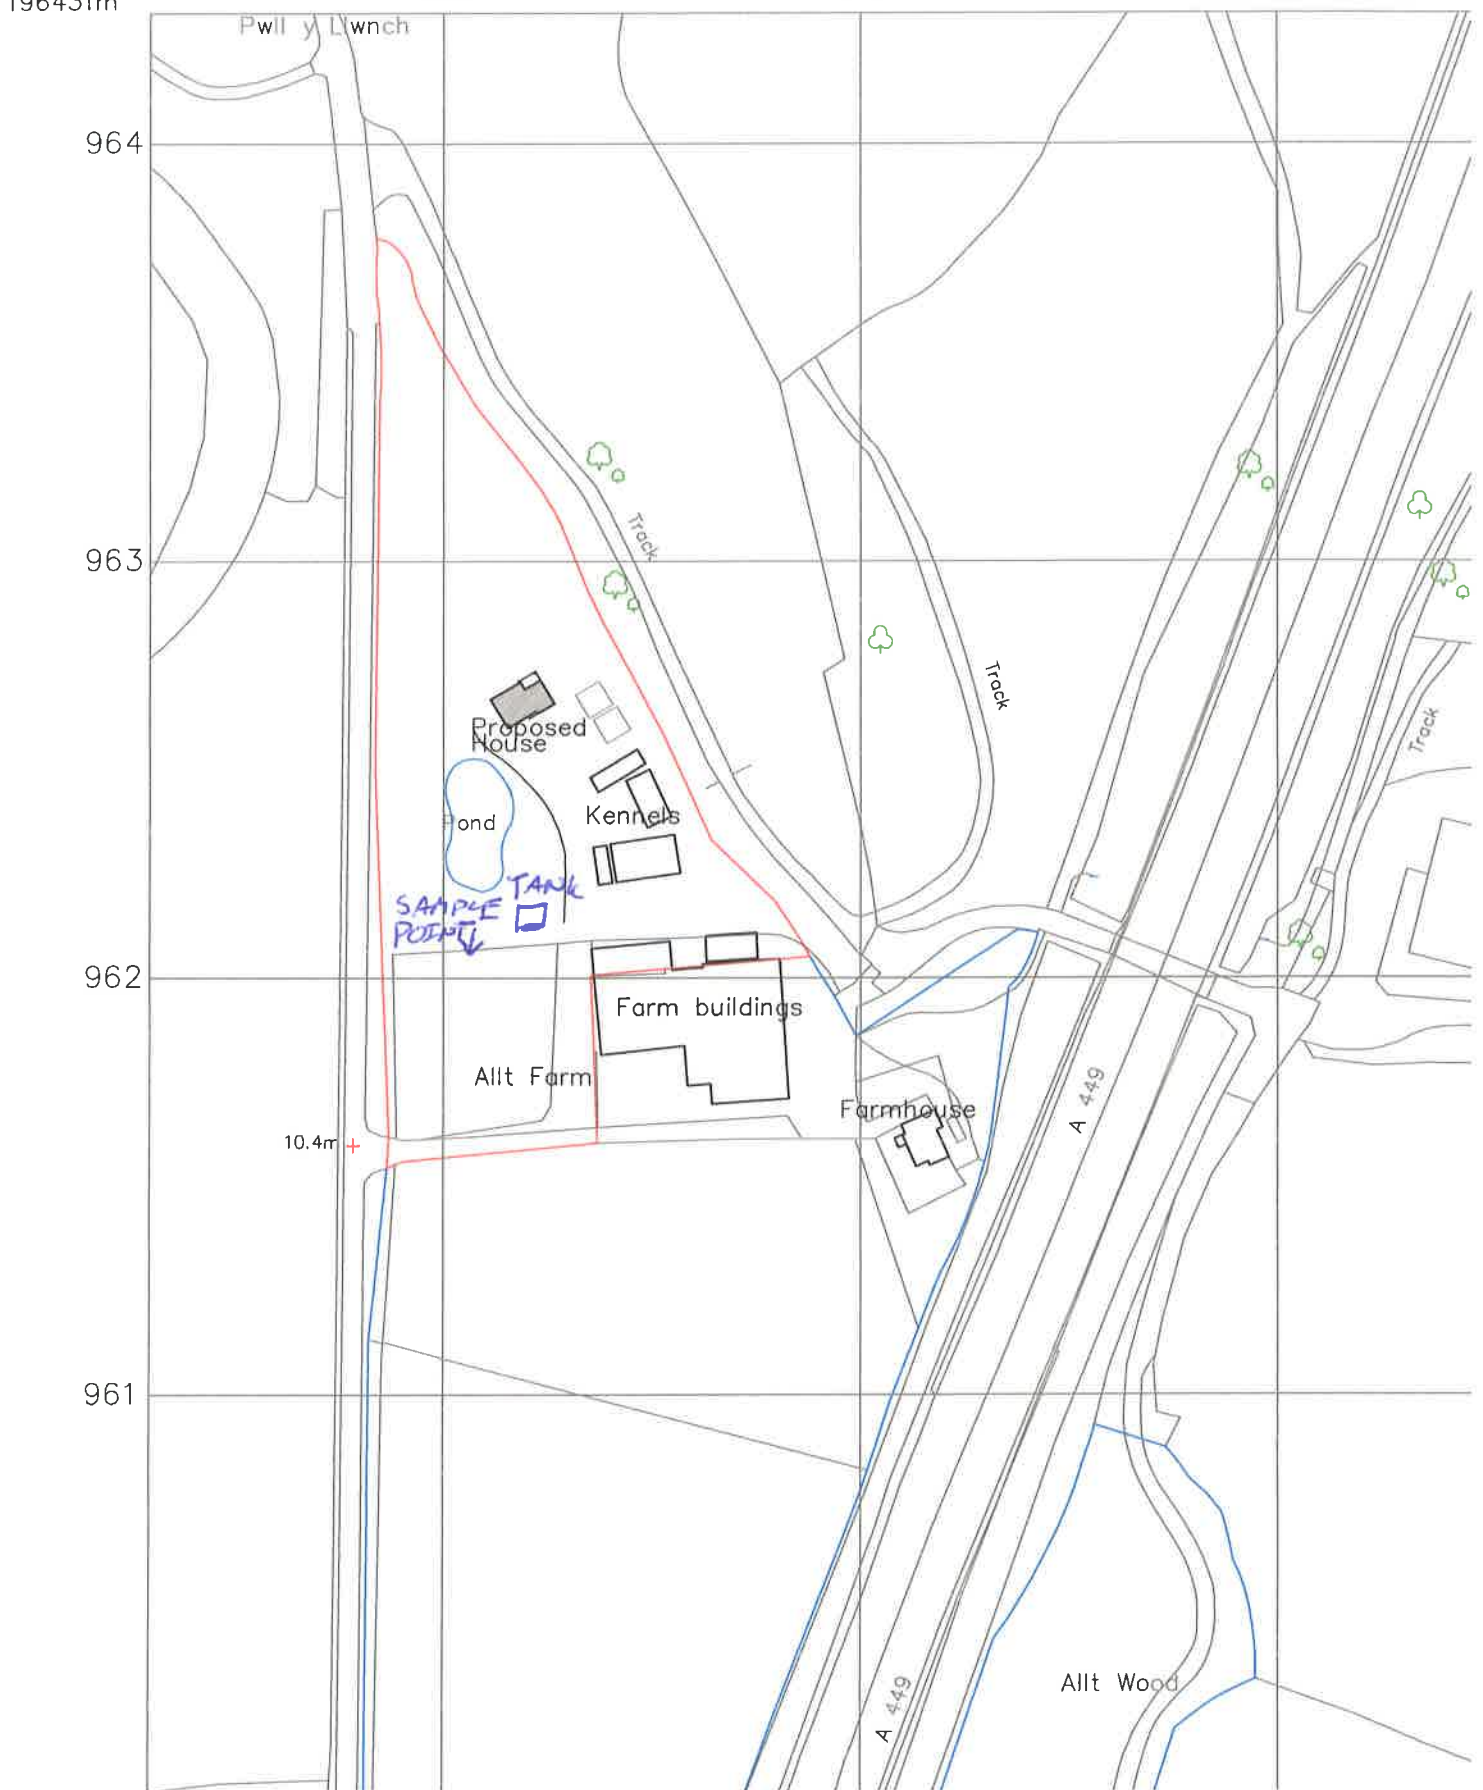

**Hernon Associates**

The Old Shop  
Kingwood  
Usk  
Monmouthshire  
NP15 1DS  
01291 690010  
liz@hernonassociates.co.uk

Status:  
☐ Preliminary  
☐ Pre-planning  
☐ Planning (Outline)  
☐ Planning (Reserved matters)  
☒ Planning (Full)  
☐ Building Regulations  
☐ Structural  
☐ Tender issue  
☐ As built  
☐ PROVISIONAL

Date:  
28.06.2018  
 Scale:  
1:1250 @ A3  
 Drawing No:  
2923-07  
 Revision:  
C

Project:  
Proposed house at  
Allt Farm,  
Usk  
 Client:  
Mr Edward James  
 Drawing:  
Location Plan

