

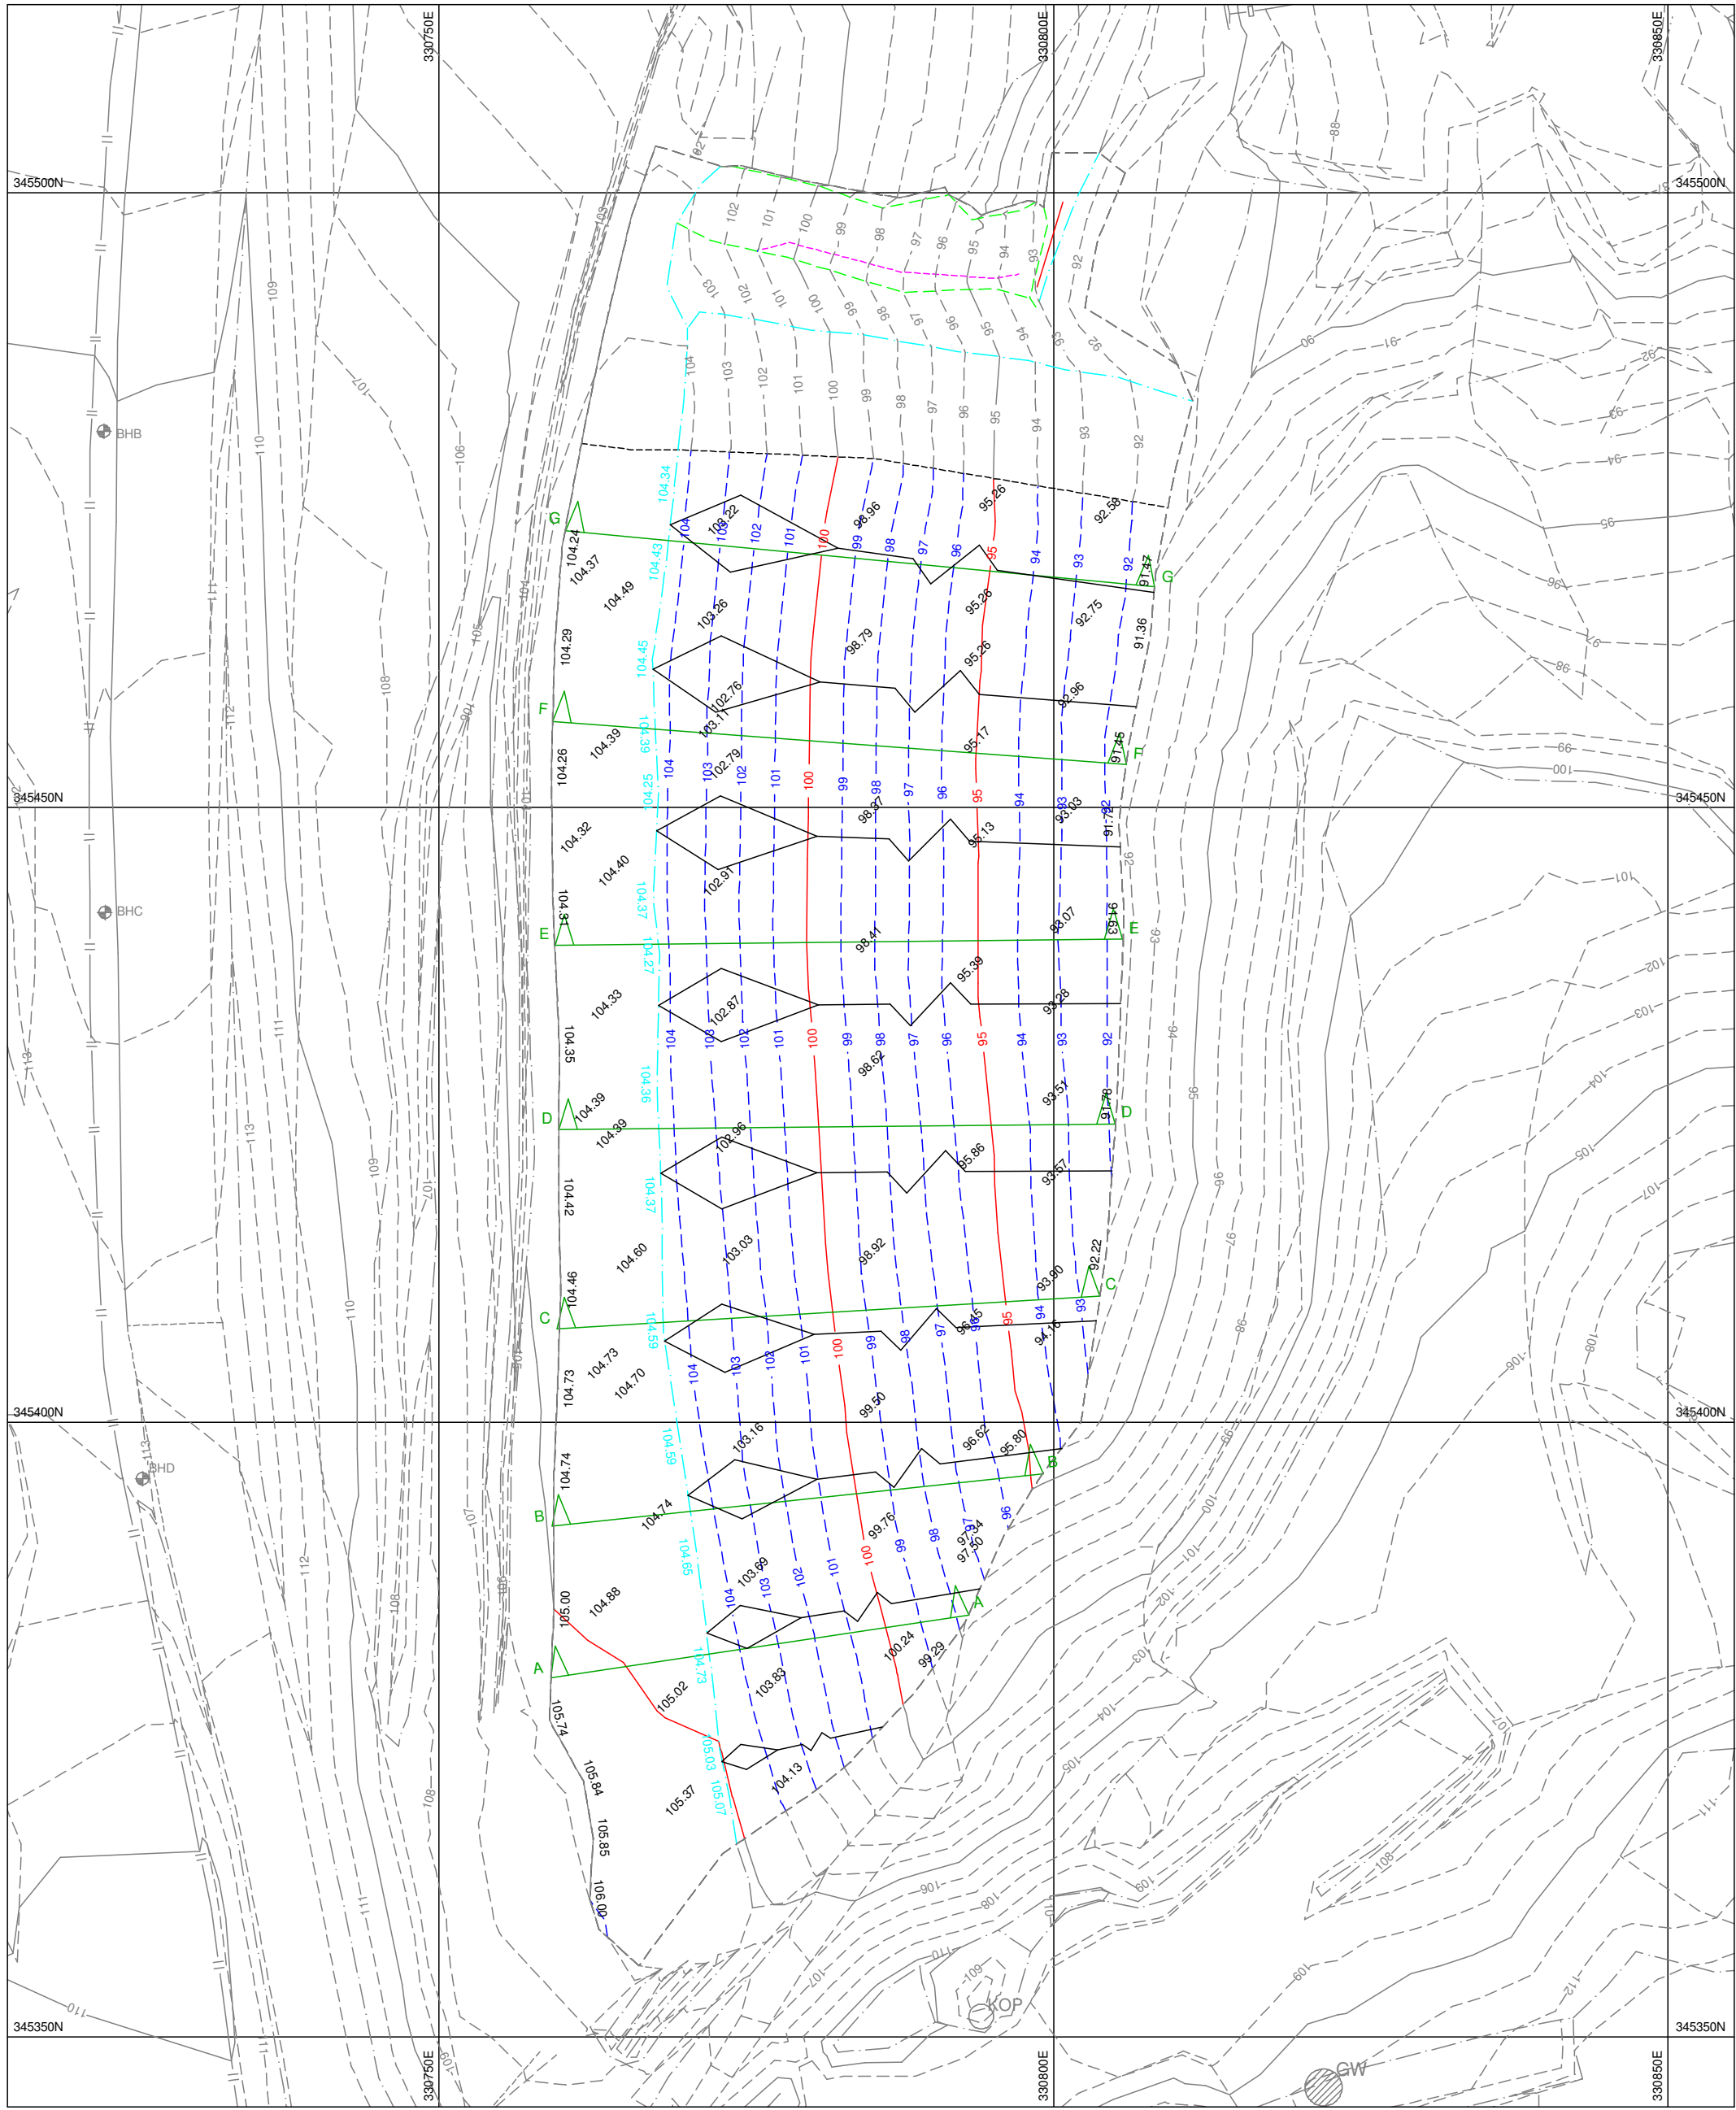
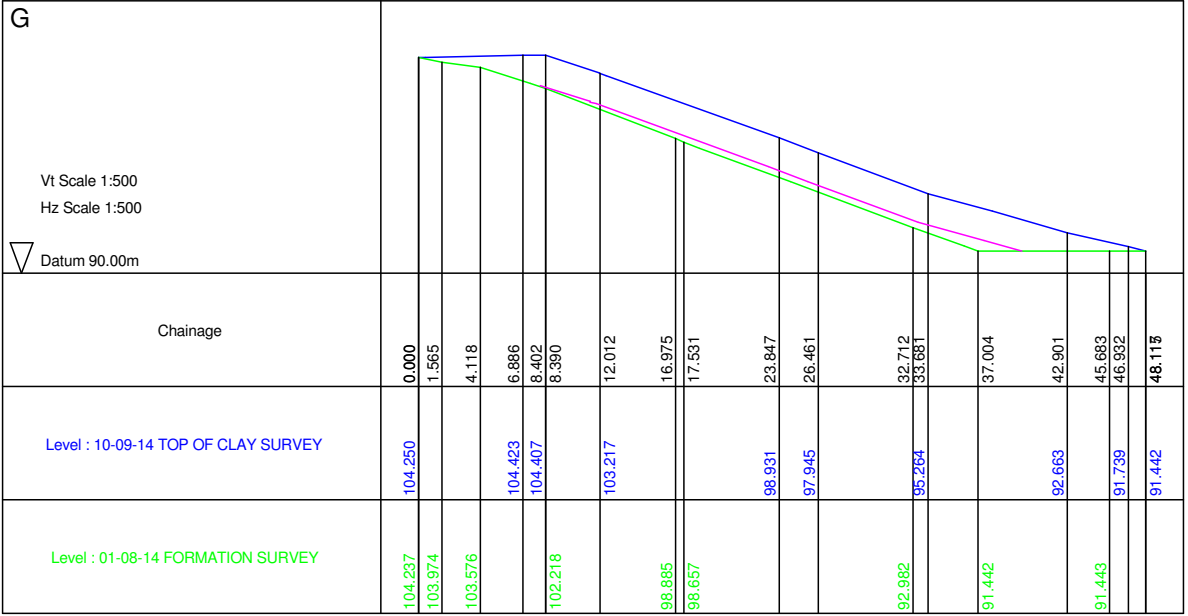
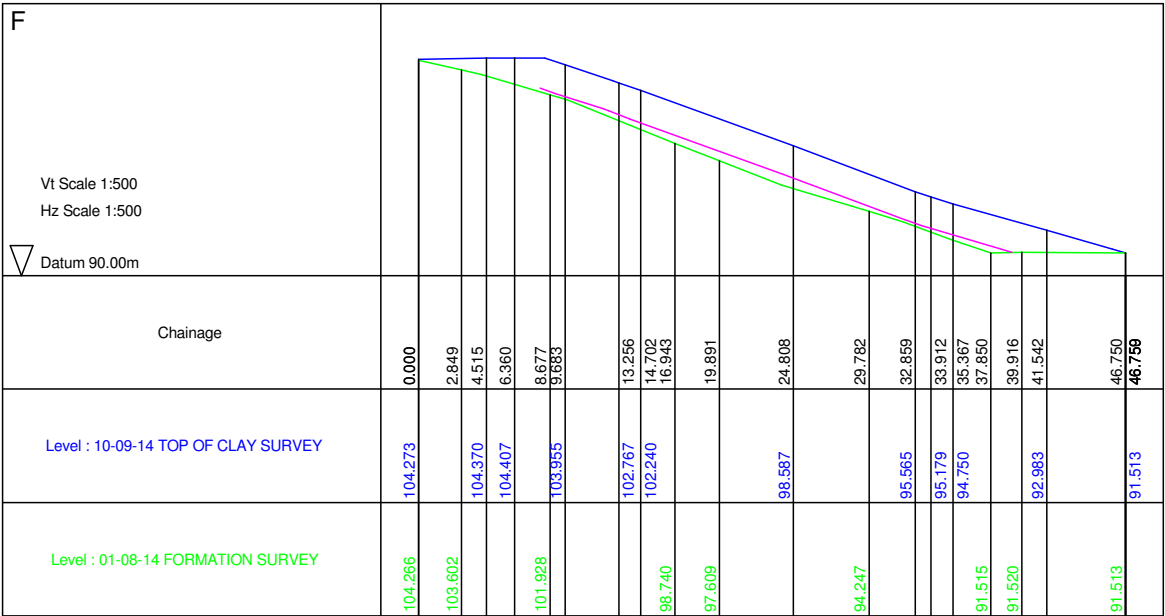
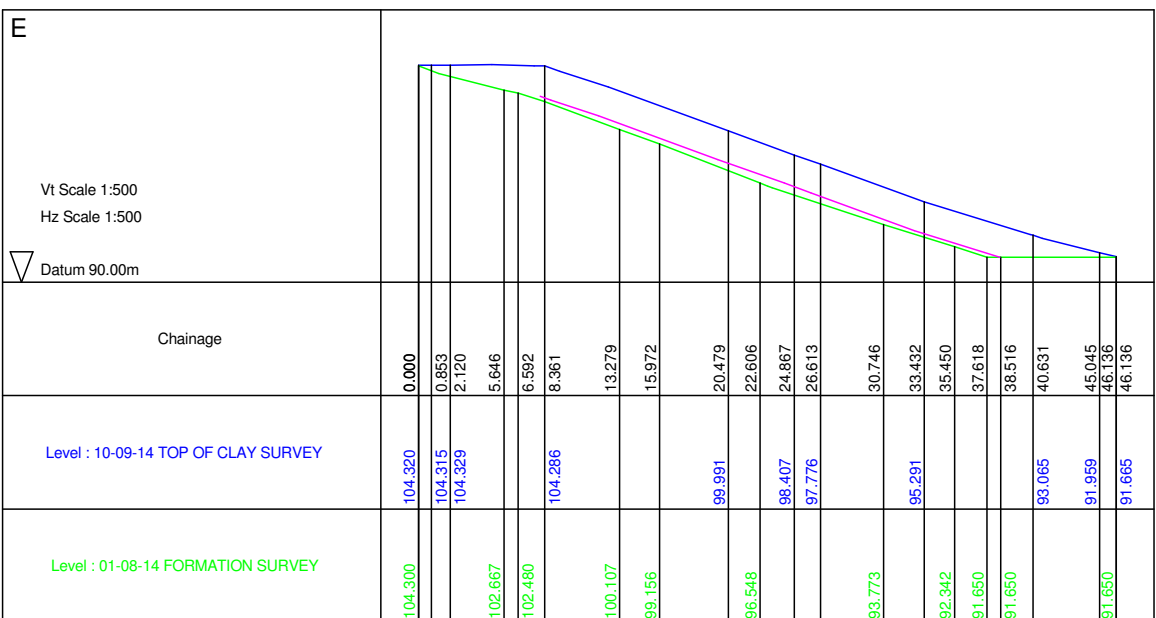
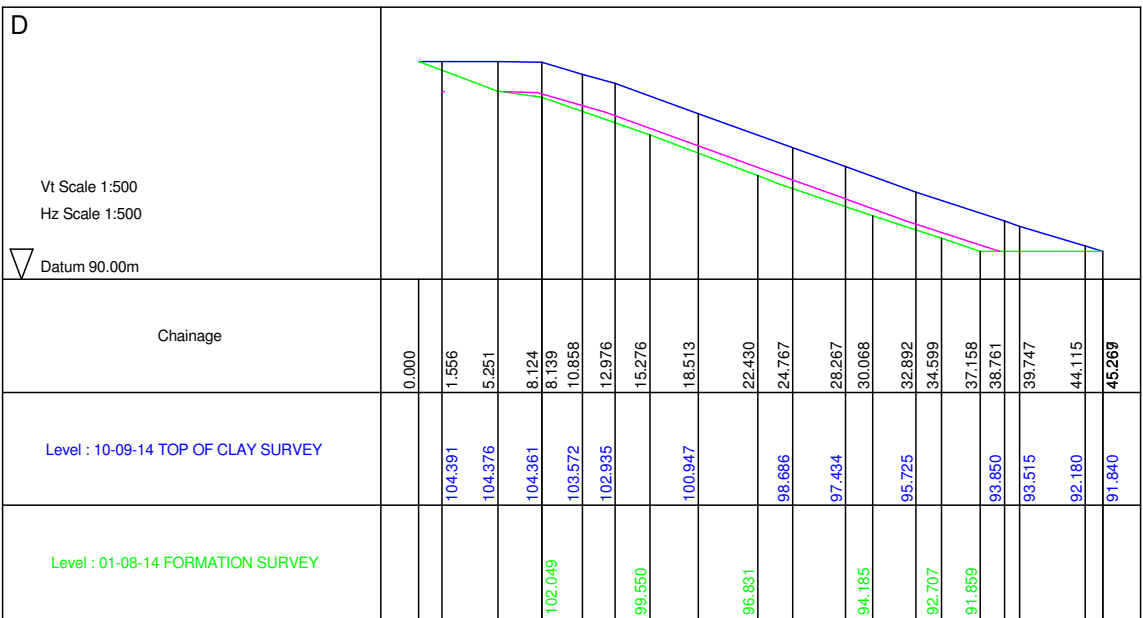
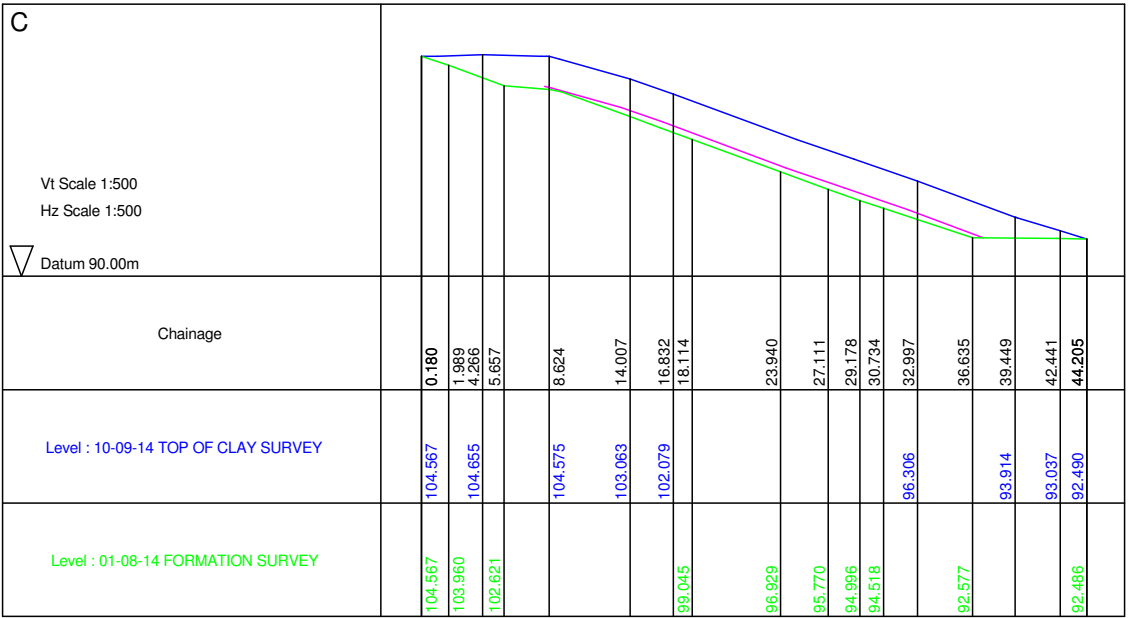


Formation Survey 01-08-2014

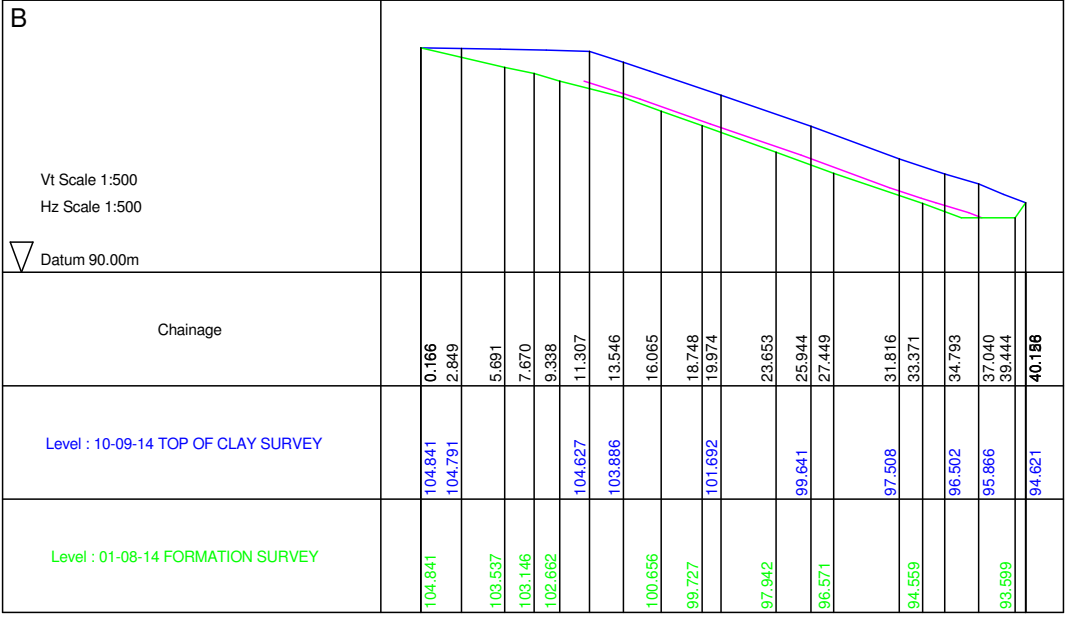

Top Of Clay Survey 10-09-2014

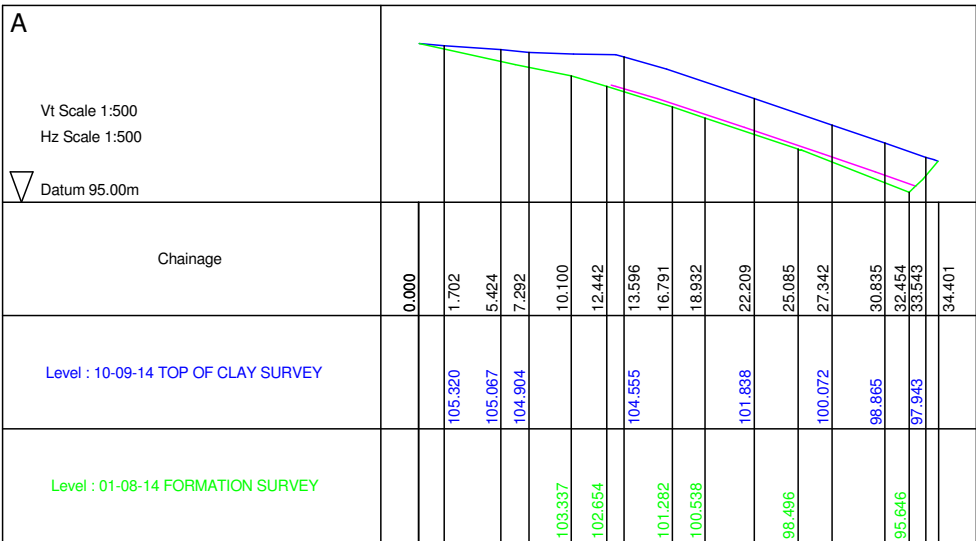

SITE

Hafod
Landfill Site

PROJECT

Cell 3 Sidewall As Built Surveys

SCALE


1:500 @ A1

DATE

September 2014

DRAWING No.

7581a Rev.1



CORY
ENVIRONMENTAL

Greyfriars Business Park
Frank Foley Way
Greyfriars
Stafford
ST16 2RF

NOTES

10-09-2024 Top Of Clay Survey

01-08-2024 Formation Survey

2m Parallel Line From Top Of Clay Survey



stafsurv
LAND SURVEYORS

www.stafsurv.com

Vernon Courtyard, Main Road, Sudbury, Derbyshire, DE8 5HS
T 01283 564900 F 01283 564644 E info@stafsurv.com