


BST.017493

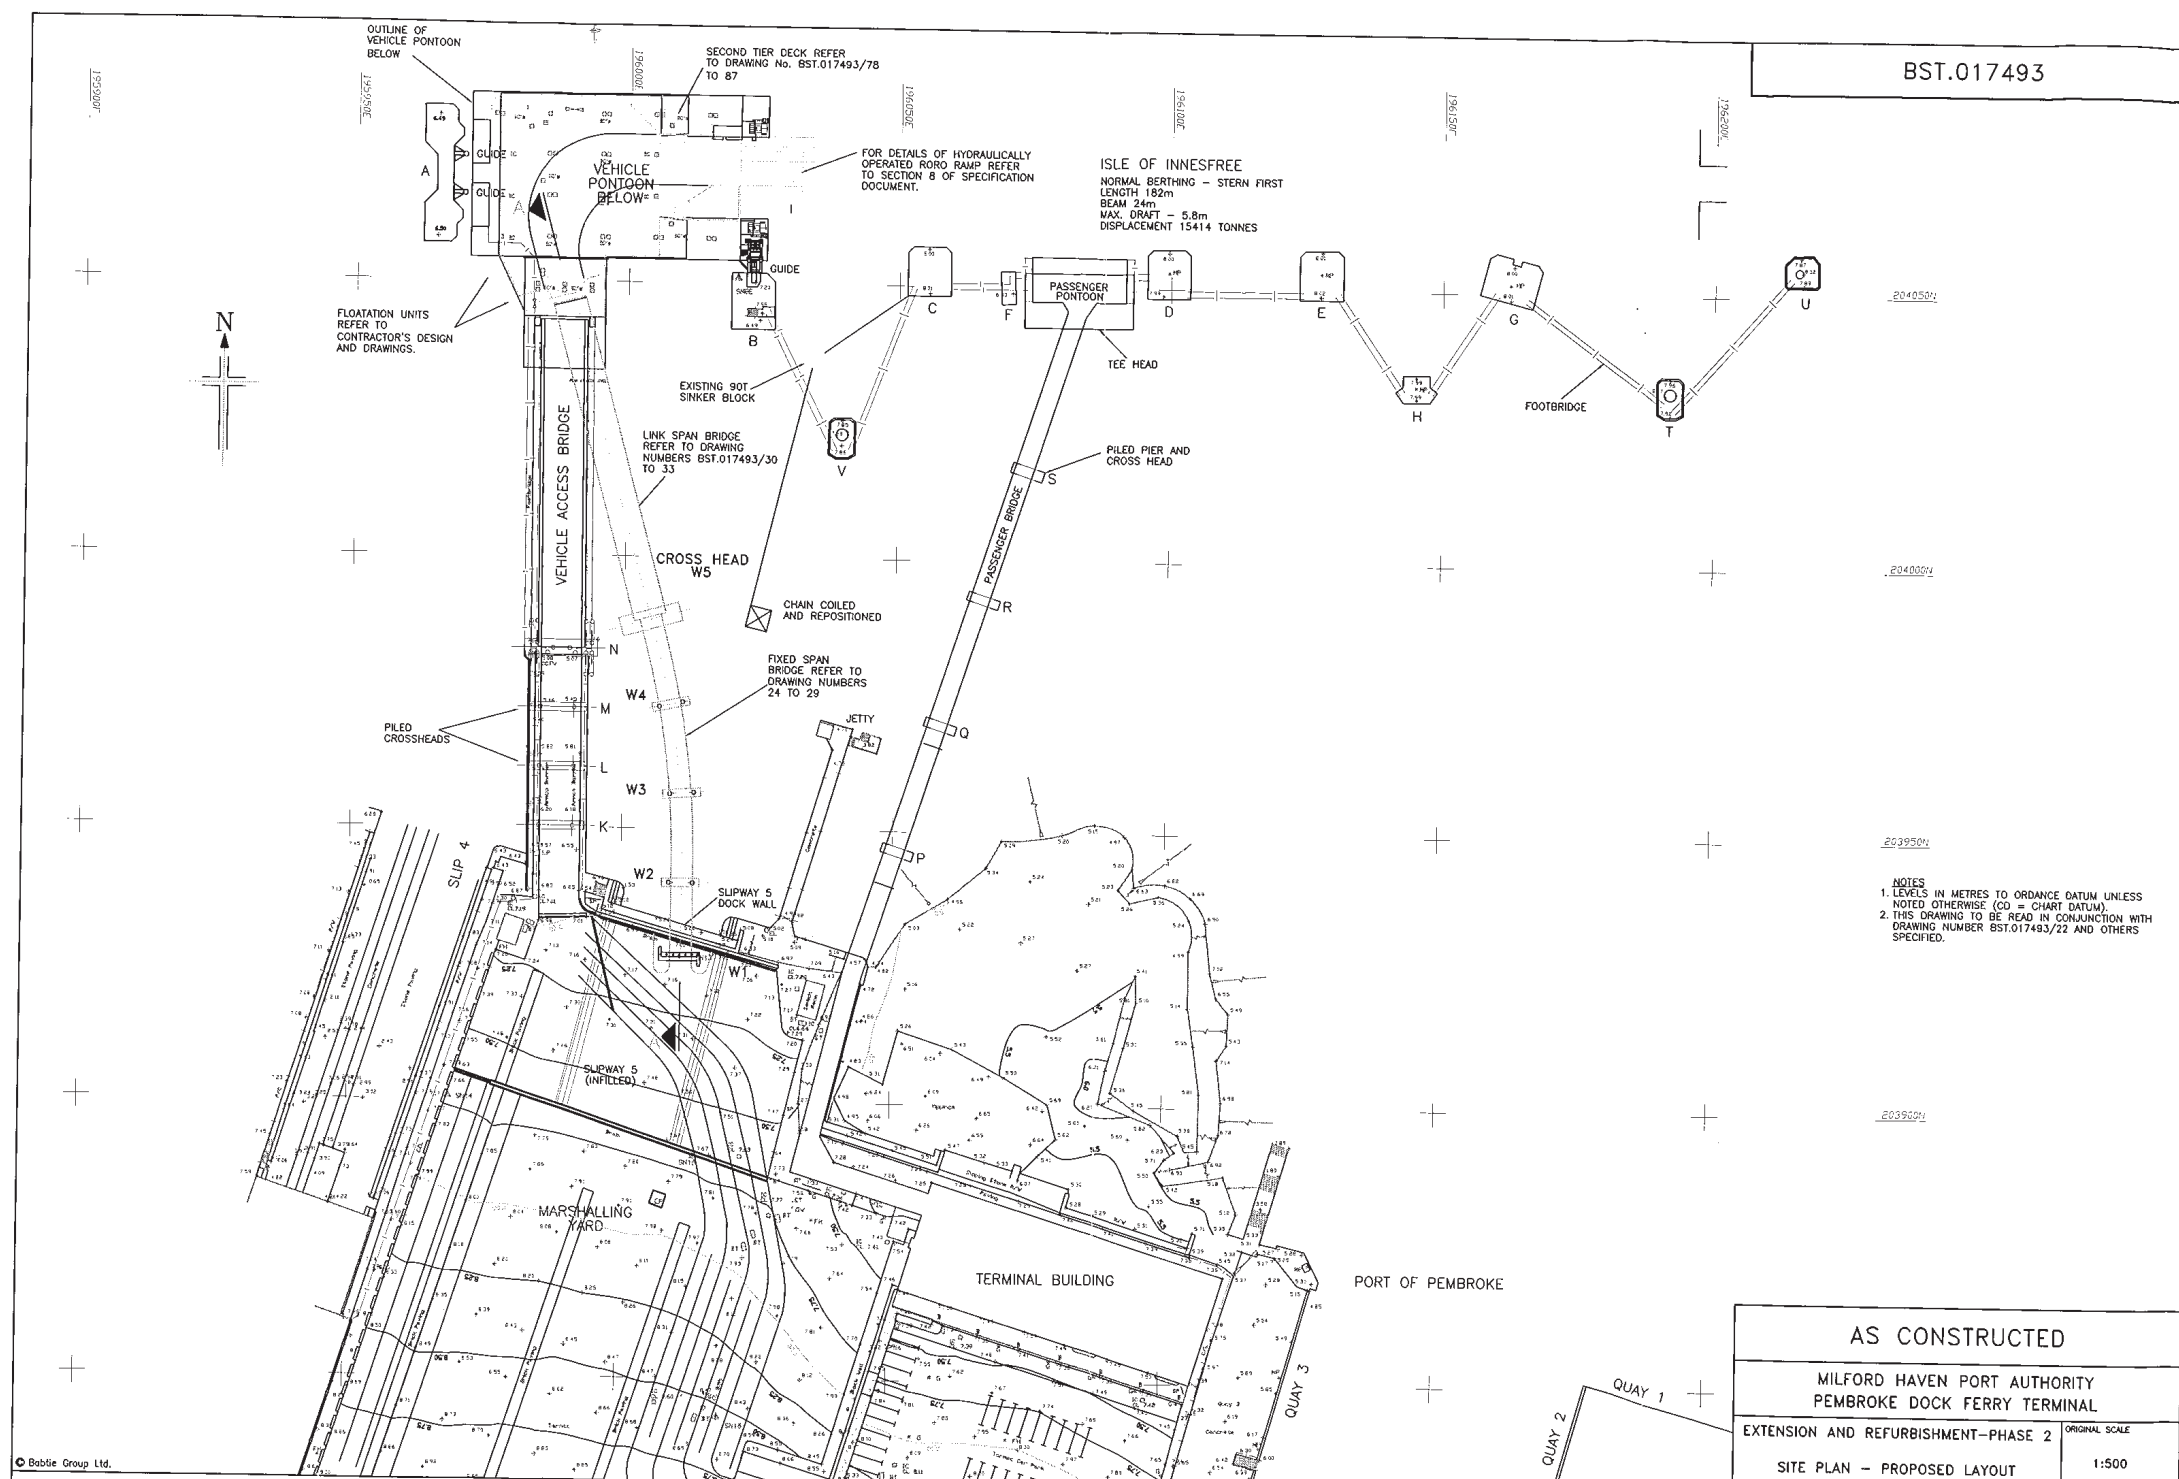

204050v

204005v

203950v

203900v

NOTES
1. LEVELS IN METRES TO ORDNANCE DATUM UNLESS NOTED OTHERWISE (OD = CHART DATUM).
2. THIS DRAWING TO BE READ IN CONJUNCTION WITH DRAWING NUMBER BST.017493/22 AND OTHERS SPECIFIED.

AS CONSTRUCTED

MILFORD HAVEN PORT AUTHORITY
PEMBROKE DOCK FERRY TERMINAL

EXTENSION AND REFURBISHMENT-PHASE 2

SITE PLAN - PROPOSED LAYOUT

ORIGINAL SCALE

1:500

DATE OCTOBER 1997

DRAWING NO. BST.017493/23

REVISIONS A B

© Babtie Group Ltd.

REV. B BY J.A.S. 1/7/99 APP'D AS CONSTRUCTED

REV. A BY M.E.R. 31/05/98 APP'D CARRIAGEWAY WIDTH AMENDED CONSTRUCTION ISSUE

REV. BY M.E.R. 27/11/97 APP'D D.J.B. TENDER ISSUE

DESIGNED	BY
DESIGNED	R.M.
CHECKED	
APPROVED	

Babtie

BABTIE GROUP
multi-disciplinary consultants
ALEXANDRA HOUSE, 307-315 COMBERGATE ROAD EAST
CARDIFF, CF5 1UD