




NOTES:

LEGEND:

NEW

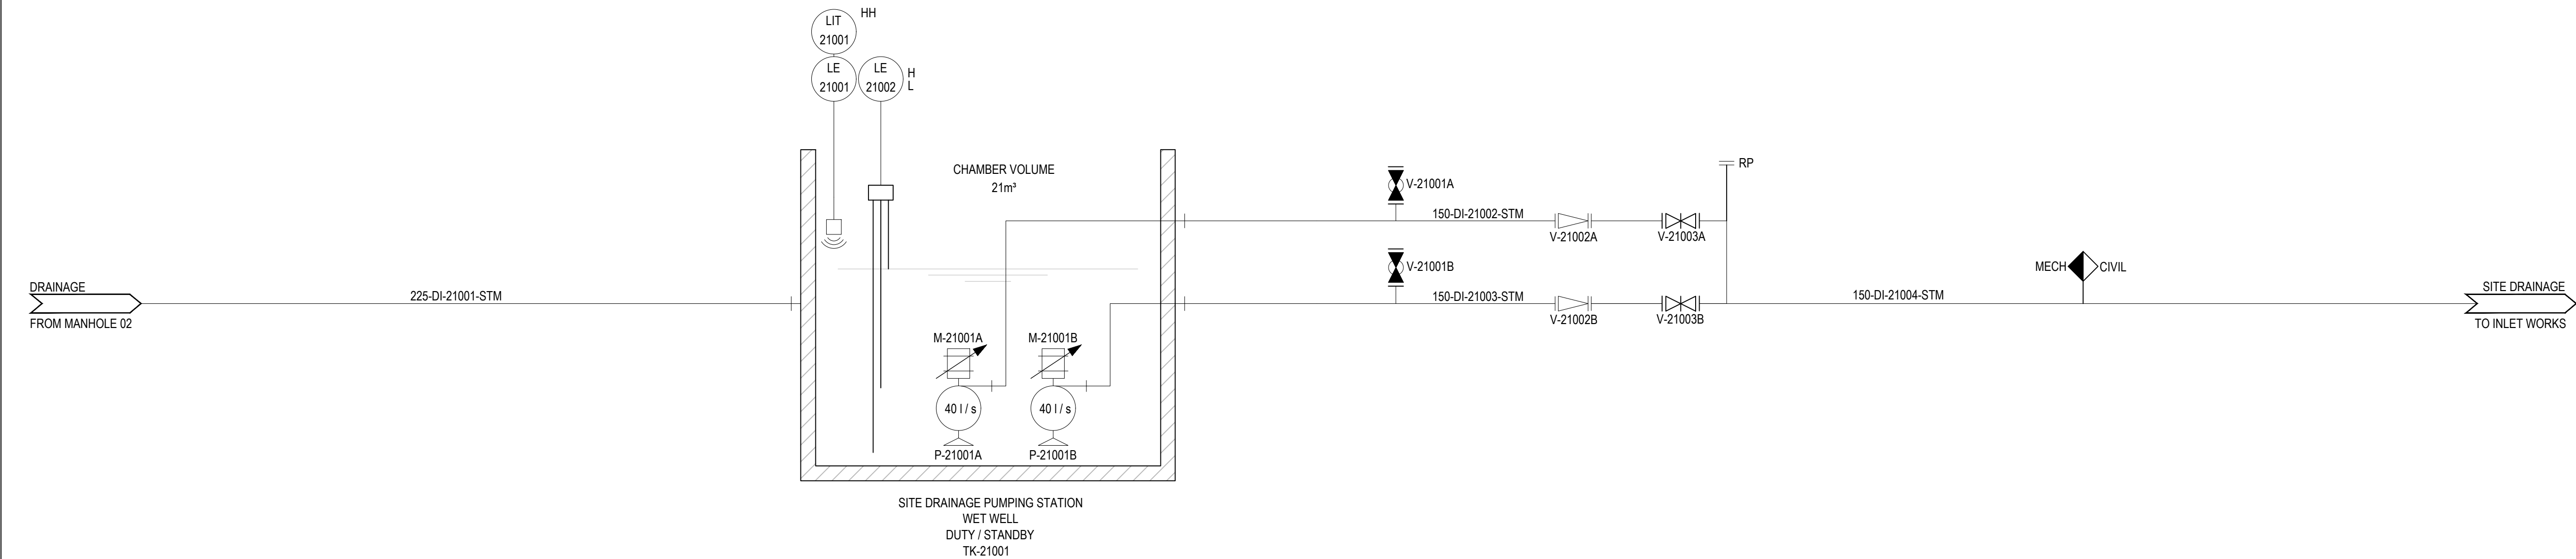

| | | | | | | |
|------|----------|------|------------------|------|------|-----------|
| Z01 | 17.10.22 | GS | AS-BUILT | SM | RG | 17.10.22 |
| C01 | 17.05.22 | SP | FOR CONSTRUCTION | RB | RG | 16.05.22 |
| Rev. | Date. | BIM. | Description. | Chk. | App. | Iss Date. |

| | | | | | |
|---|--|--------------------|--------------------------------------|--|--|
| <div><div><div>Capital Delivery Alliance</div><div>Cyngghrair Cyflawni Cyfalaf</div><div>Ty Awon, Spooner Close, Coad Kernen, Newport, NP108FZ</div></div></div> | | | | | |
| Project Name: | | | QUEENSFERRY WwTW - IED | | |
| Drawing Title: | | | SITE RETURNS PUMPING STATION P&ID | | |
| Suitability: | | | | Suitability Code: | |
| AS-BUILT | | | | AB | |
| Originator: SP | | Designer: VC | | Date: 18.04.22 | |
| Internal Project Number: SV19 | | Scale: NTS @ A1 | | Rev: Z01 | |
| Drawing Number: B16383-123532-09-BG-DR-ZA-PR0049 | | | | <div><div><div>MMB</div><div>MOTT MACDONALD MUTILEY</div></div></div> | |

Dwr Cymru Cyf gives this information as to the position of its underground apparatus by way of general guidance only on the strict understanding that it is based on the best information available and no warranty as to its correctness is relied upon in the event of excavations or other works made in the vicinity of the company's apparatus and any onus of locating the apparatus before carrying out any excavations rests entirely on you. It must be understood that the furnishing of the information is entirely without prejudice to the provision of the New Roads and Streetworks Act 1991 and of the Company's right to be compensated for any damage to its apparatus.

Dwr Cymru Cyf has no duty to identify private apparatus and the information as to the position of the private apparatus is given by way of general guidance only on the strict understanding that it is based on the best information available and no warranty as to its correctness is relied upon. Not all private apparatus is identified but their presence should be anticipated.