


Unit: 1mm = 1m Date: 24-Jan-23 By: Ben Stocks

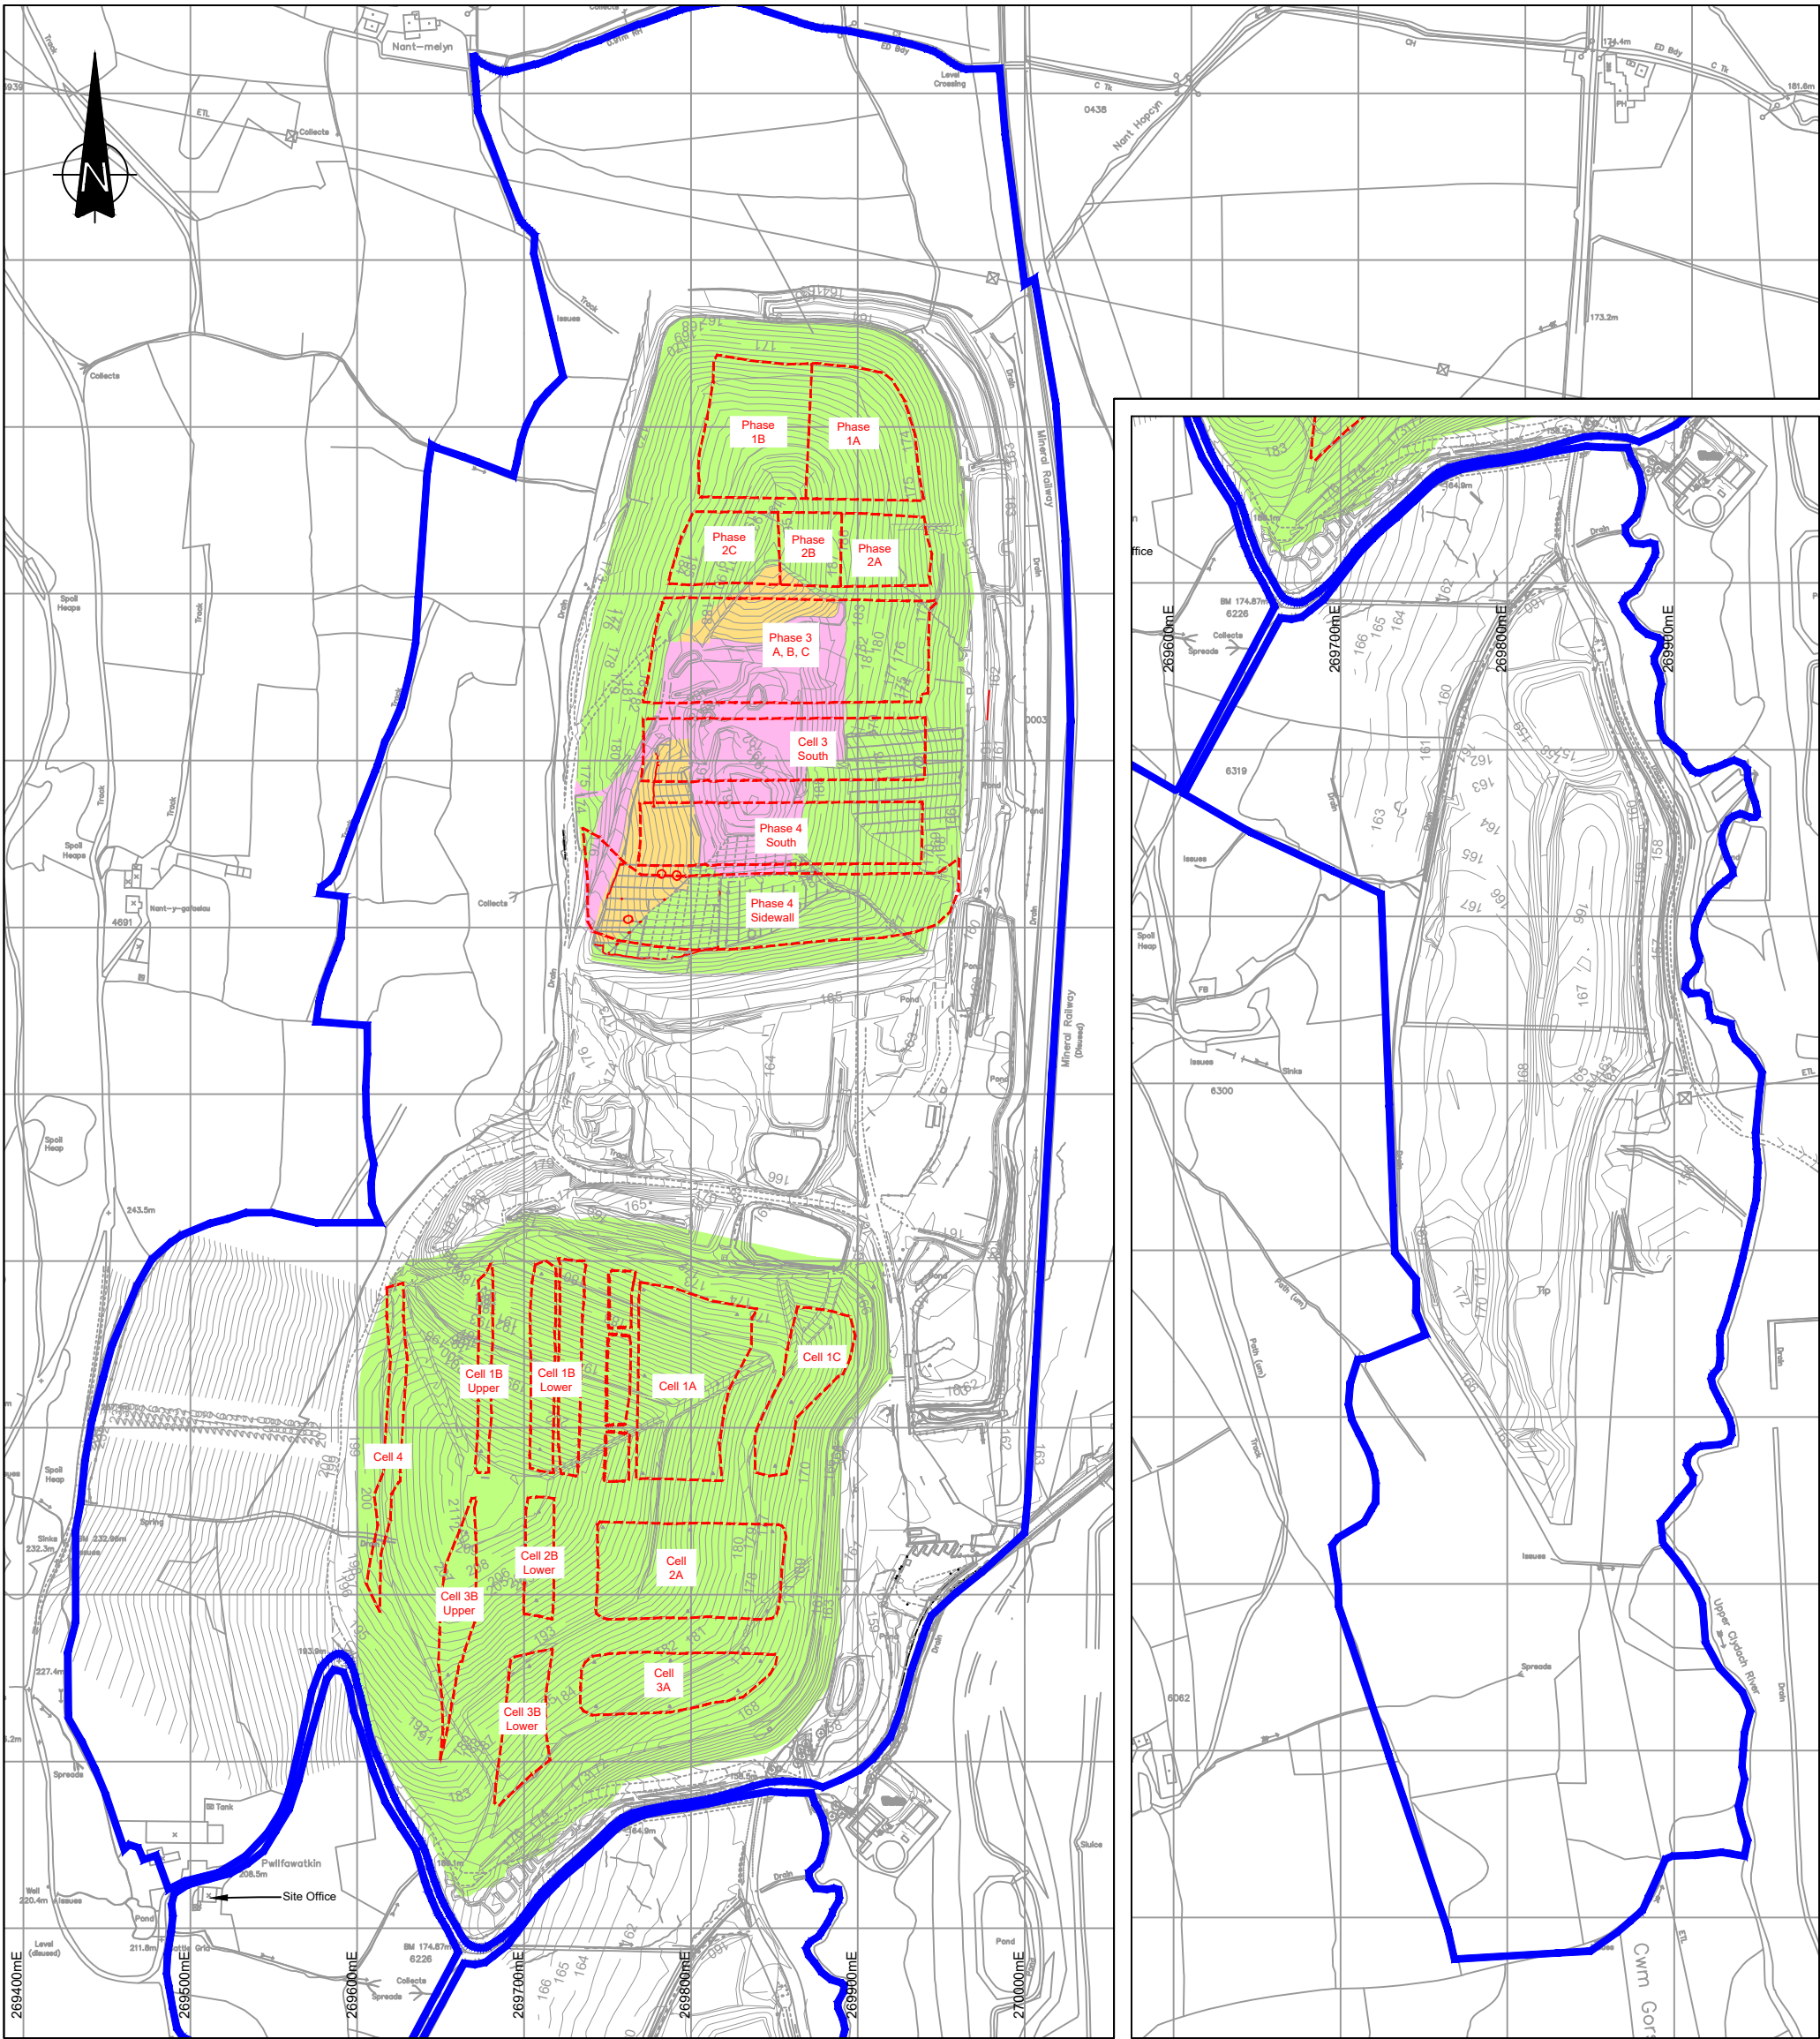

LEGEND:

- Ownership Boundary
- Open Waste Area
- Proposed Area
- Temporary Capped Area
- Permanently Capped
- Construction Area
- Latest Available Ground Contours
- As-built Cell Footprint

NOTES:

1. ALL DIMENSIONS IN MILLIMETRES AND ALL LEVELS IN METRES ABOVE ORDNANCE DATUM.

2. DO NOT SCALE FROM THIS DRAWING.

3. ANY ANOMALIES IDENTIFIED WITH THE DETAILS SHOWN ON THIS DRAWING ARE TO BE BROUGHT TO THE ATTENTION OF FCC ENVIRONMENT (UK) LIMITED PRIOR TO CONSTRUCTION WORKS COMMENCING.

Reference files:
Information taken from plans;
Site Survey: 479W2440
Area Models: 479A2442

Reproduced from Ordnance Survey Digital maps with the permission of the Controller of Her Majesty's Stationary Office. © Crown copyright. FCC Environment (UK) Limited, 3 Sidings Court, White Rose Way, DONCASTER DN4 5NU. Licence No 0100031673

FCC Environment
3 Sidings Court, White Rose Way, Doncaster. DN4 5NU

Site: **PWLLFAWATKIN LANDFILL SITE**

Drawing Title: **Annual Site Plan 2023**

Drawn By: BS	Checked By: LH	Date: 24.01.23	Scale: 1:4000	Paper Size: A3
Status: FINAL	Revision: -	Drawing No: 479A483	Plan Number: PLAN 2	

Revision:	Date:	Description:	By:	Chk:
-	-	-	-	-
-	-	-	-	-
-	-	-	-	-