




Drawn	Approved	Date
PM	XX	14/11/2025

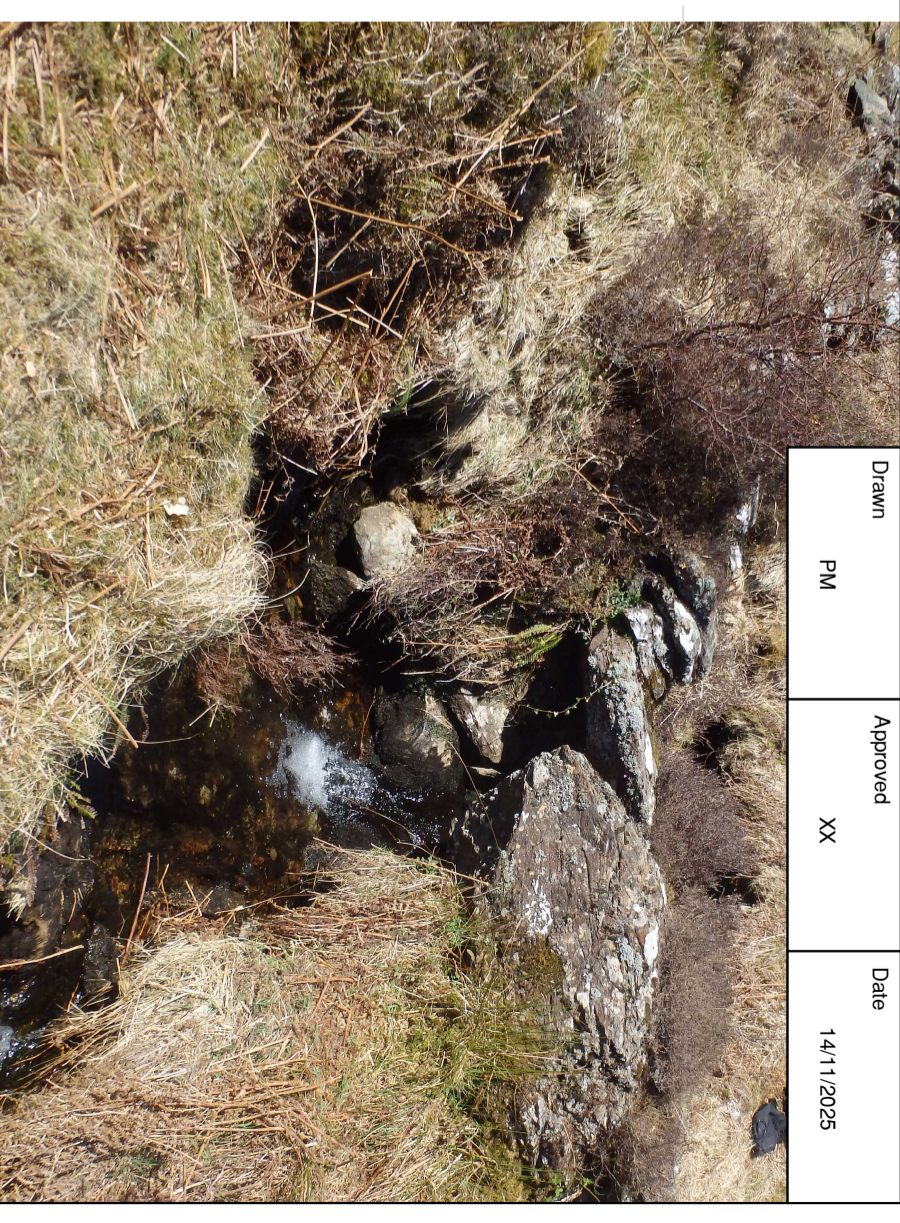

1 - 1  
Long section

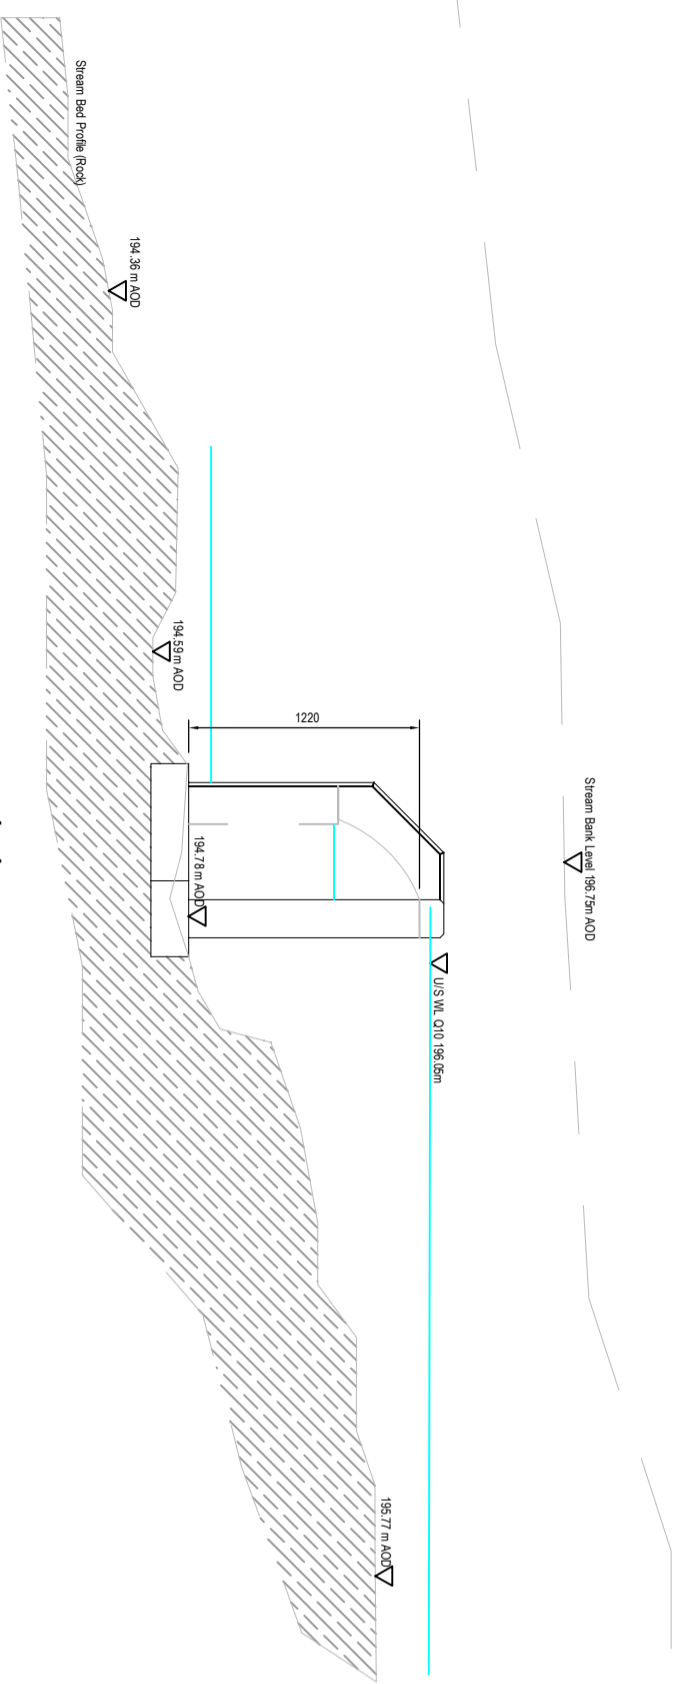

2 - 2  
Cross section

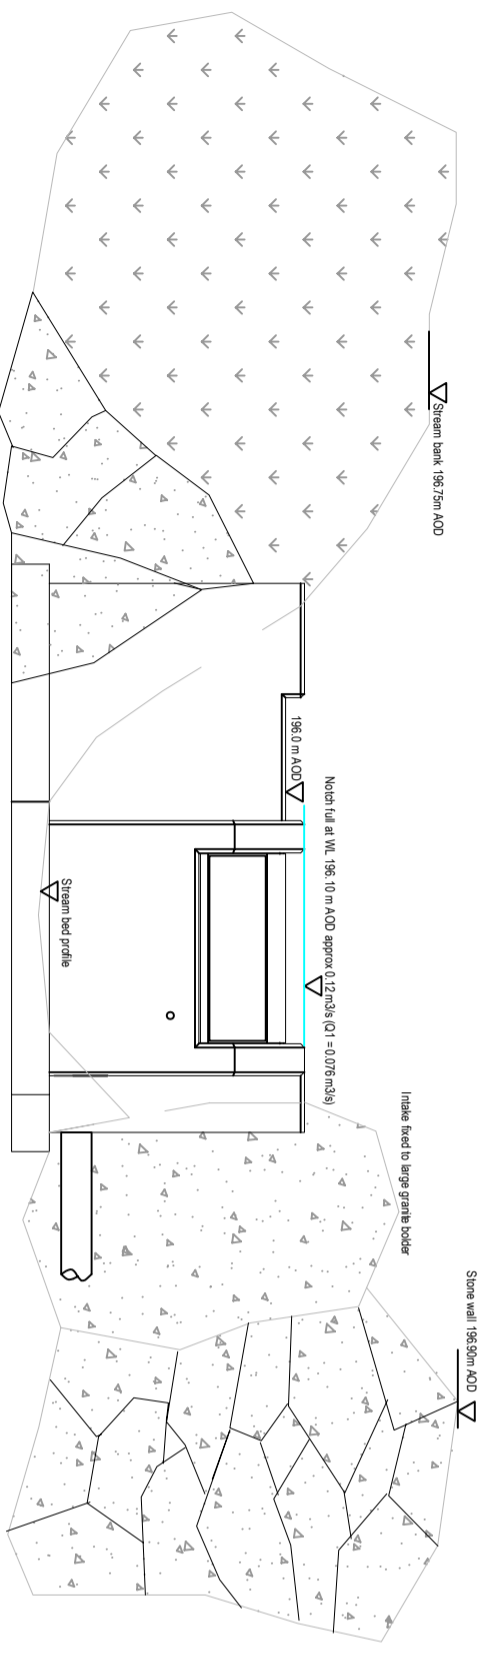

Notes

Stage	As Built
-------	----------

Drawing Long Section and cross section of as built intake

Job 326 Clogwyn HEP NRW Abstraction License WA/065/0006/007

<p><b>Hydromatch Ltd</b> 10 Fore Street Uffculme Devon United Kingdom EX15 3AN</p> <p>Tel: +44(0)1884 798869 Email: consulting@hydromatch.com www.hydromatch-consulting.co.uk</p>		Drawing No.	Version
		A.03	2
Scale	1:40	Sheet	A3