
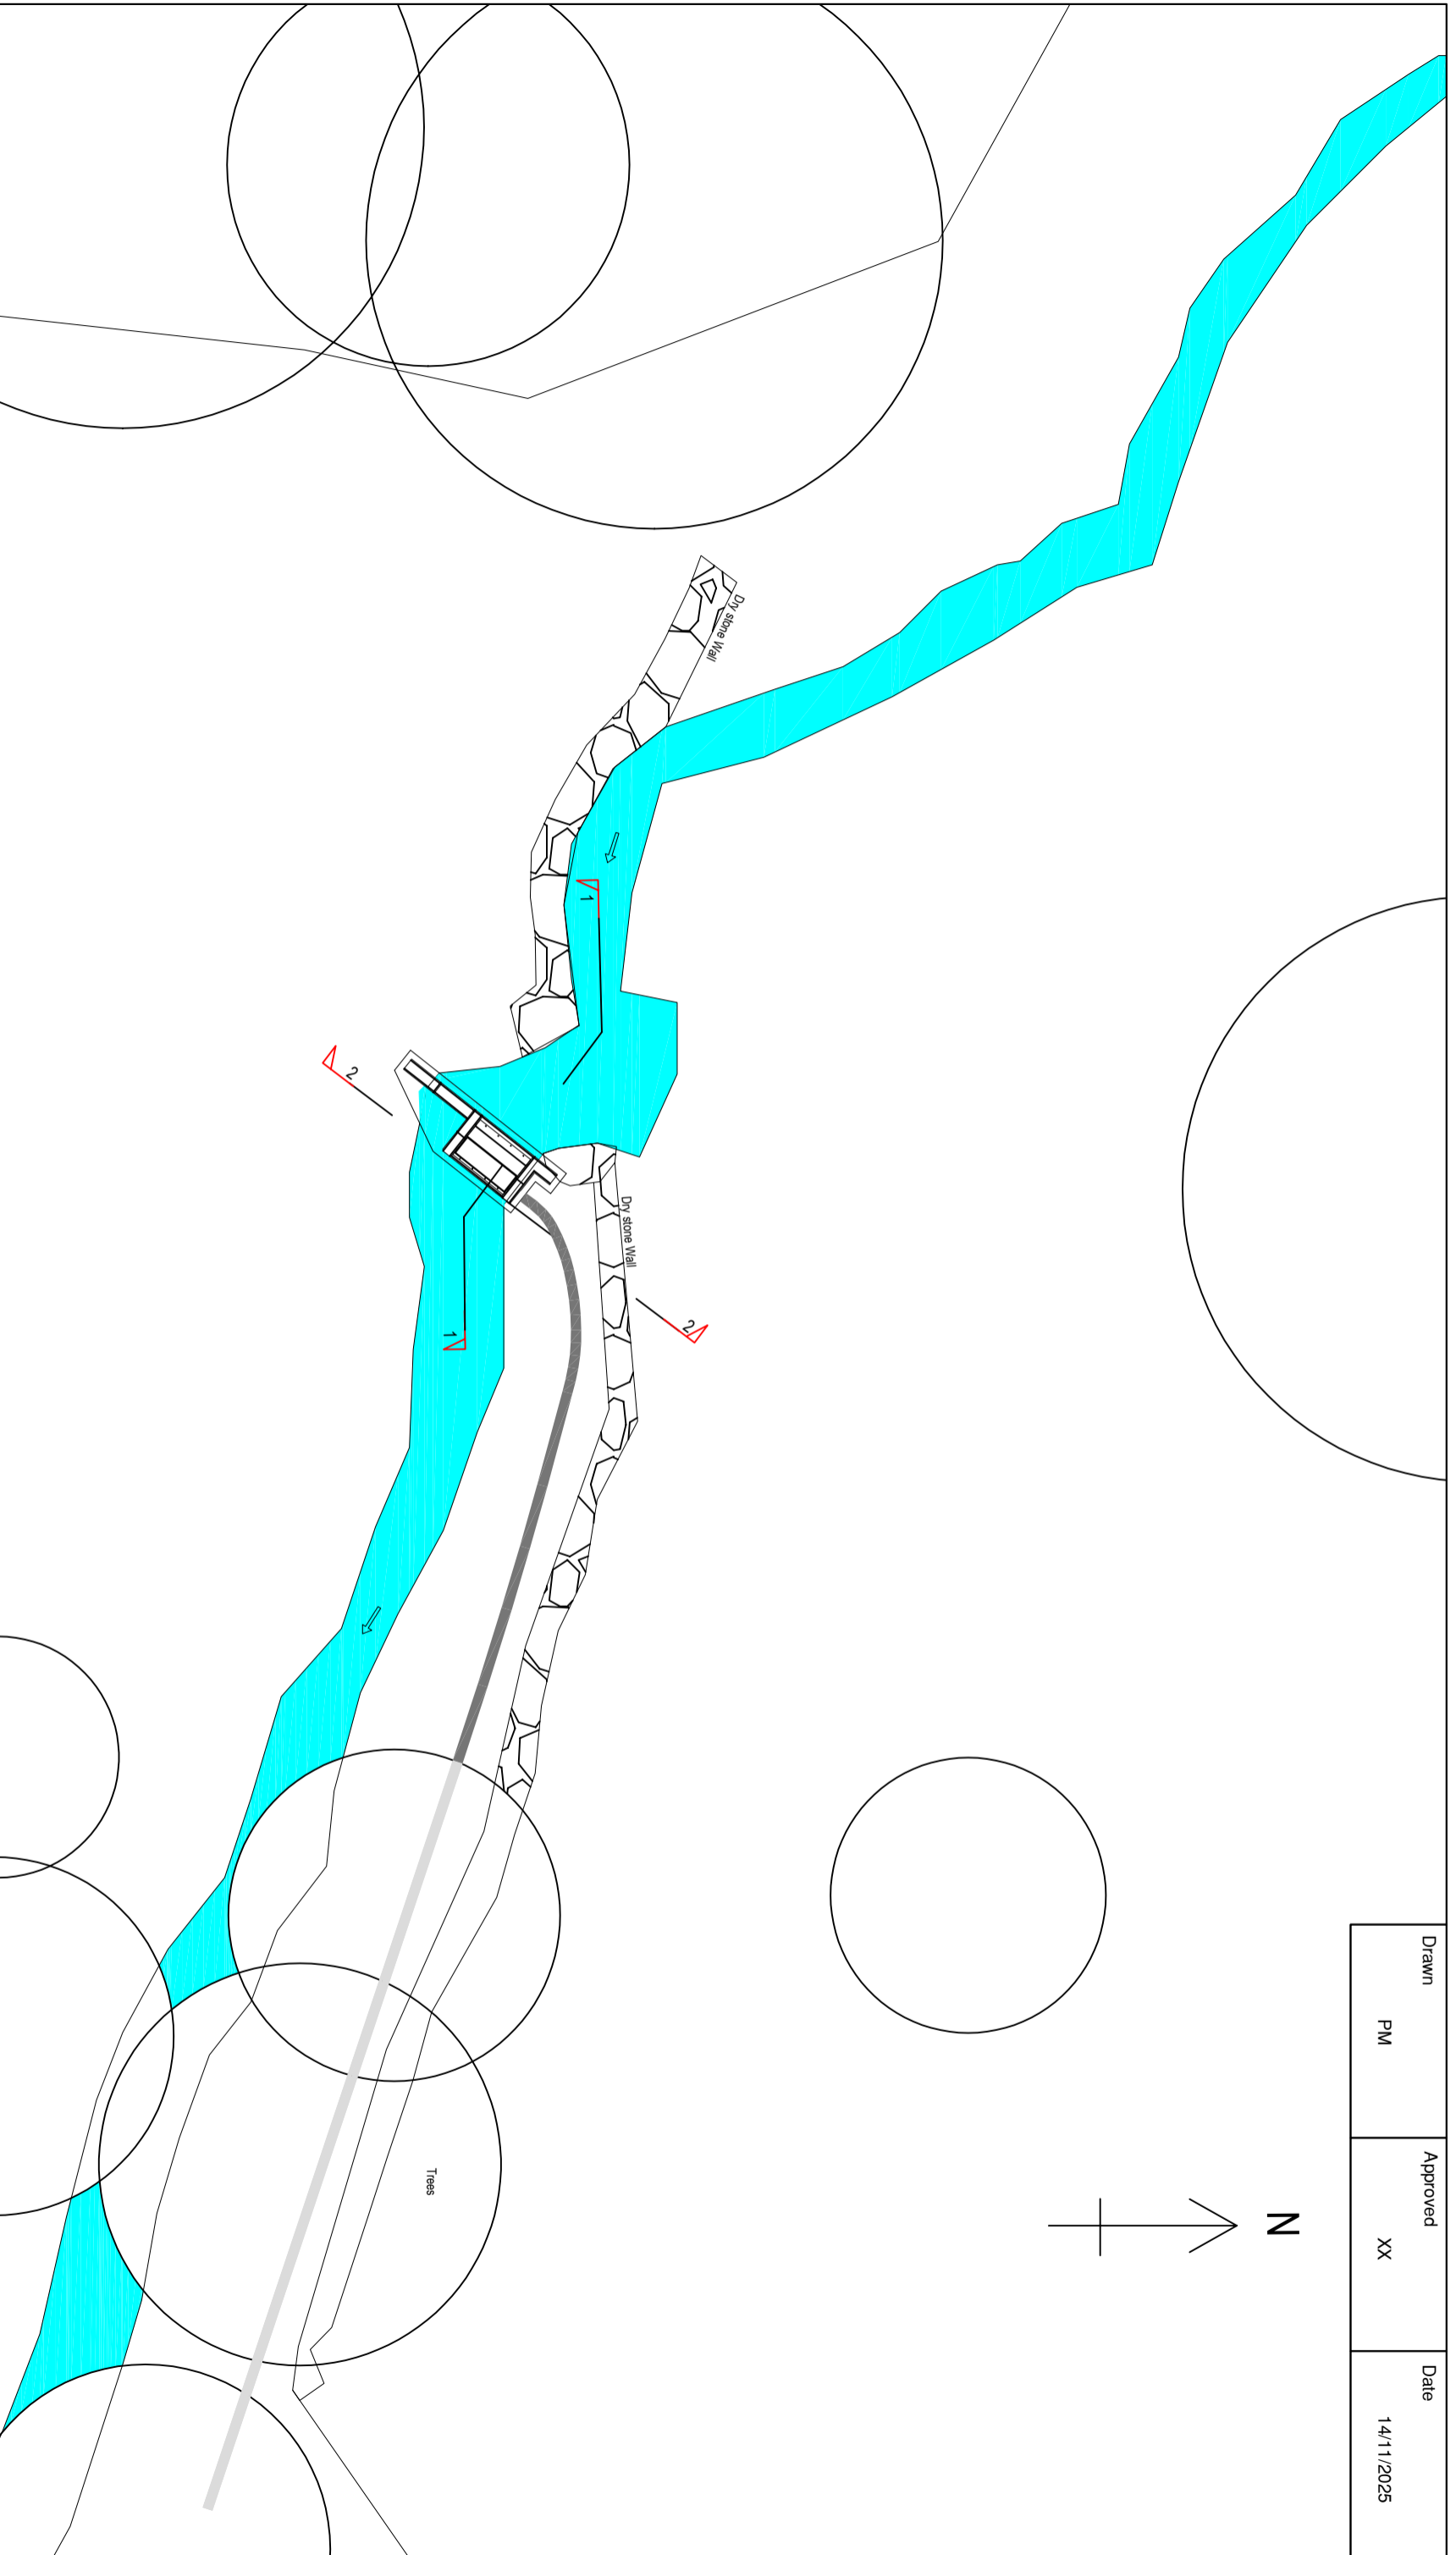


Drawn	Approved	Date
PM	XX	14/11/2025

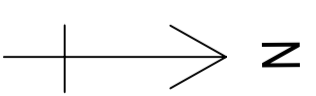

Notes	
Stage	As Built

Drawing	Layout plan identifying local features - As Built Intake Structure
Job	326 Clogwyn HEP NRW Abstraction License WA/065/0006/007

**Hydromatch Ltd**  
 10 Fore Street  
 Uffculme  
 Devon  
 United Kingdom  
 EX15 3AN

Tel: +44(0)1884 798869  
 Email: consulting@hydromatch.com  
 www.hydromatch-consulting.co.uk

Drawing No.	A.02	Version	1
Scale	1:100	Sheet	A3

