



Drawn	Approved	Date
PM	XX	15/05/2026

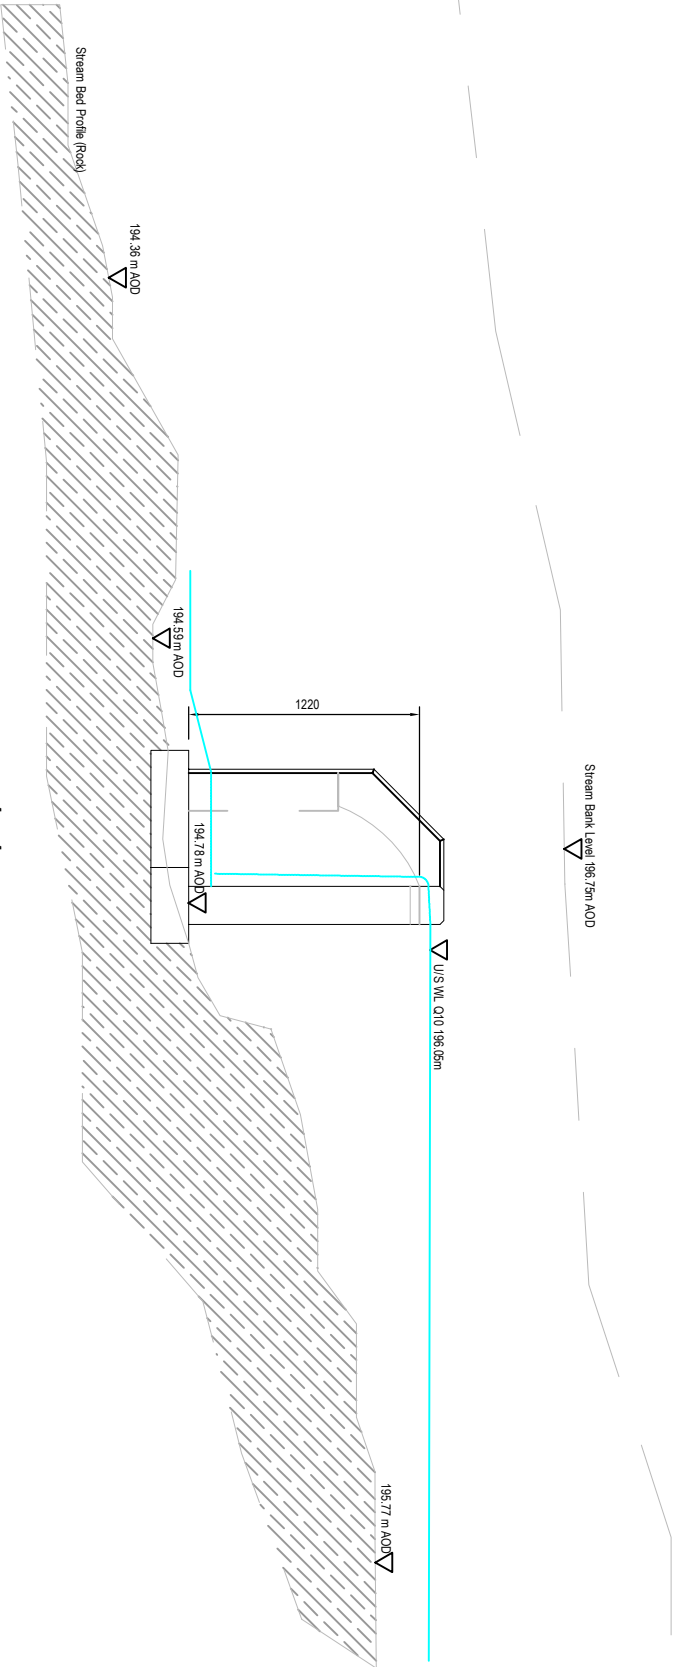

1 - 1
Long section



2 - 2
Cross section

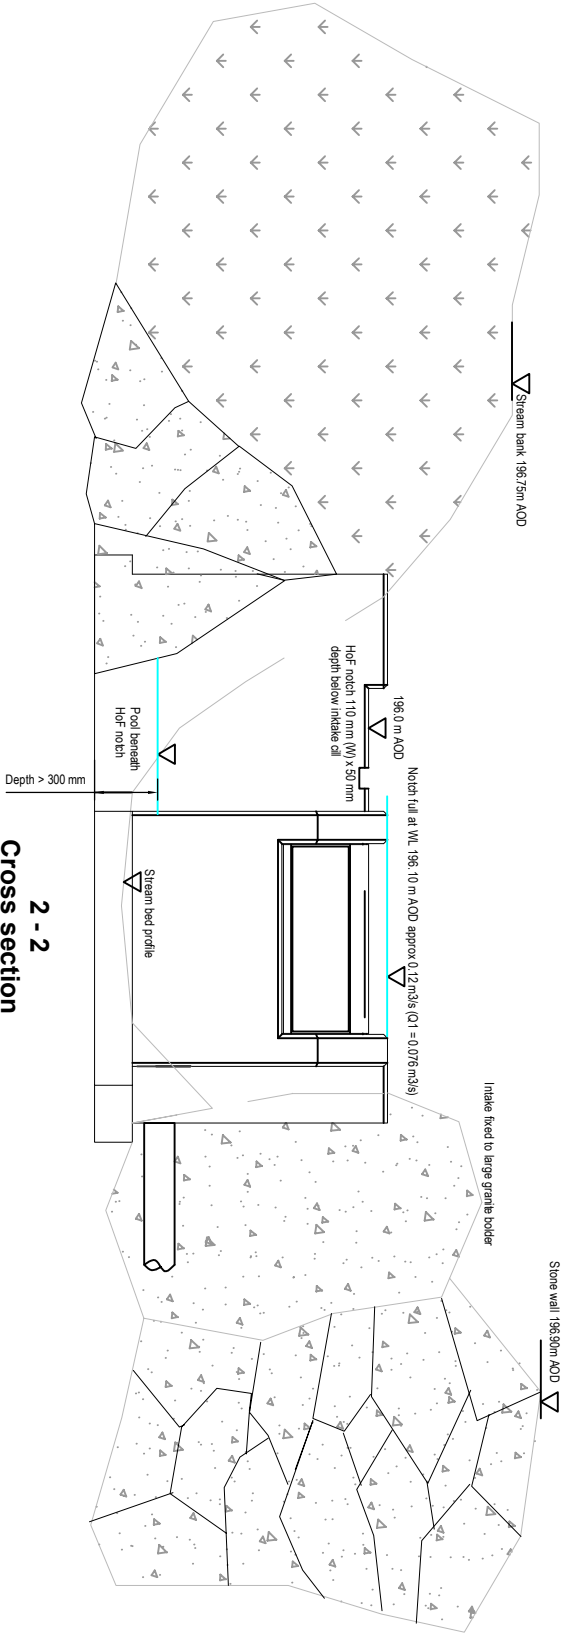

Notes

Drawing Long Section and cross section of as built intake

Job 326 Clogwyn HEP NRW Abstraction License WA/065/0006/007

Hydromatch Ltd 10 Fore Street Uffculme Devon United Kingdom EX15 3AN Tel: +44(0)1884 798869 Email: consulting@hydromatch.com www.hydromatch-consulting.co.uk		Drawing No. A.03	Version 3
Scale 1:40		Sheet A3	

Stage As Built