




Drawn	Approved	Date
PM	XX	28/05/2026

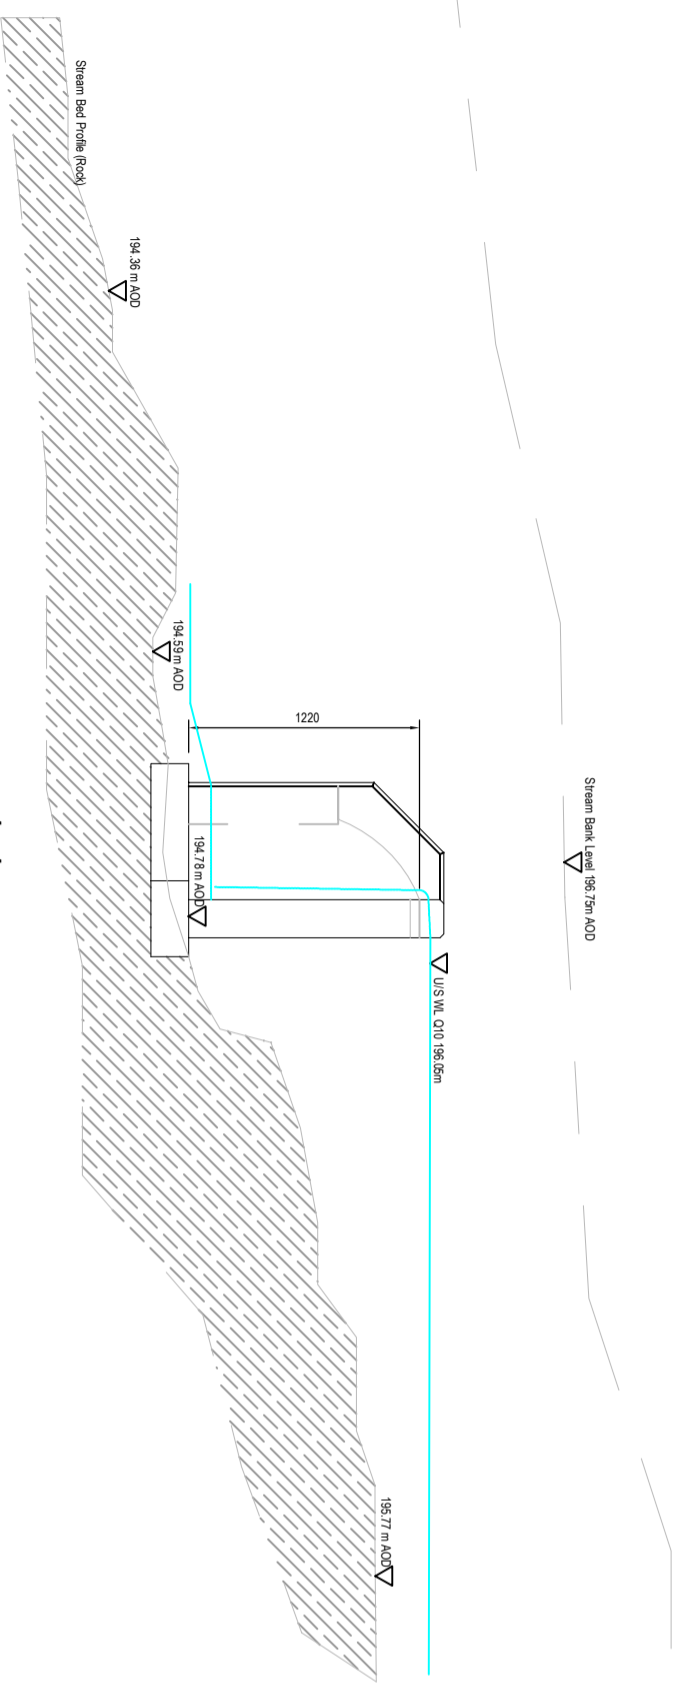

1 - 1
Long section

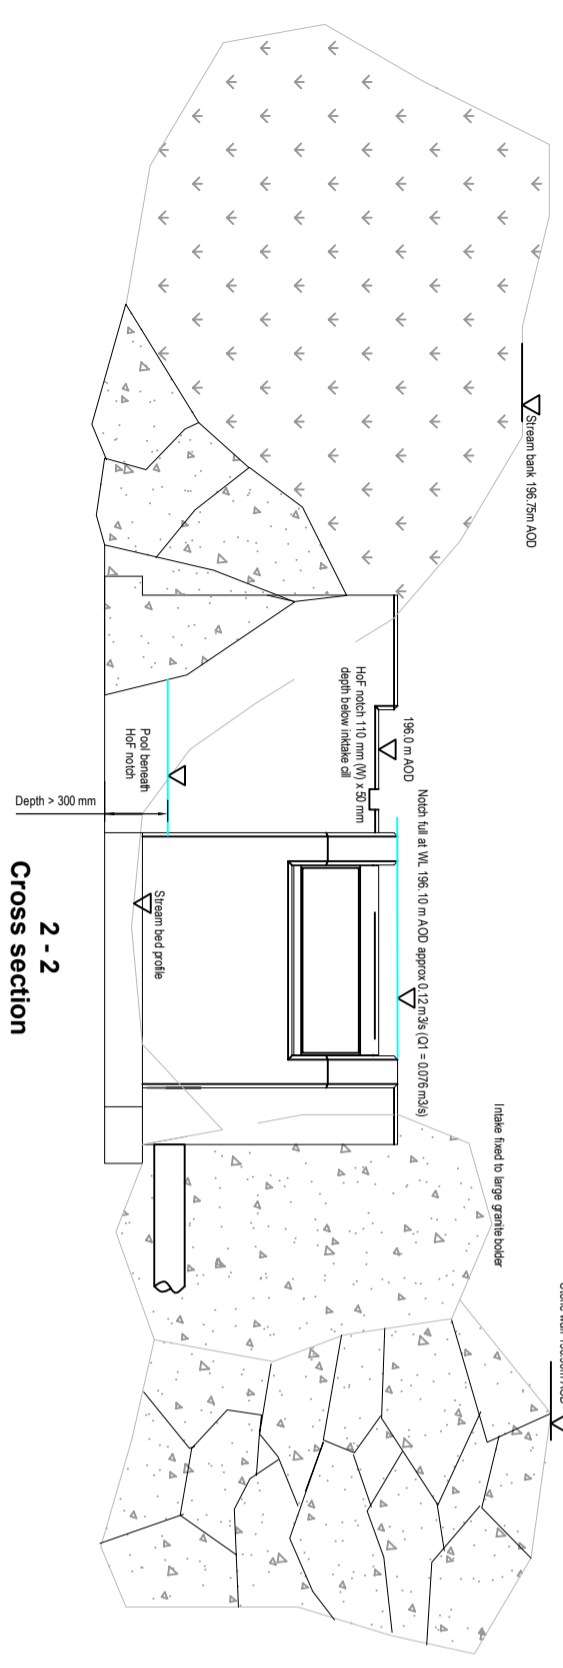

2 - 2
Cross section

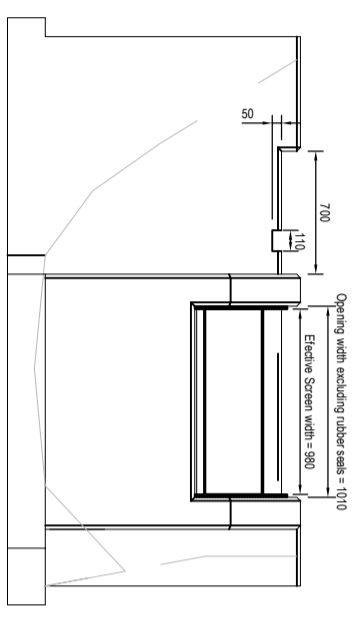

2 - 2
Cross- Section with crest dimensions

Notes
All dimensions in millimetres unless shown otherwise

Stage	As Built
-------	----------

Drawing Long Section and cross section of as built intake

Job 326 Clogwyn HEP NRW Abstraction License WA/065/0006/007

<p>Hydromatch Ltd 10 Fore Street Uffculme Devon United Kingdom EX15 3AN</p> <p>Tel: +44(0)1884 798869 Email: consulting@hydromatch.com www.hydromatch-consulting.co.uk</p>	Drawing No.	Version
	A.03	4
Scale	Sheet	
1:40	A3	