


DO NOT SCALE

0 10 100
Millimetres

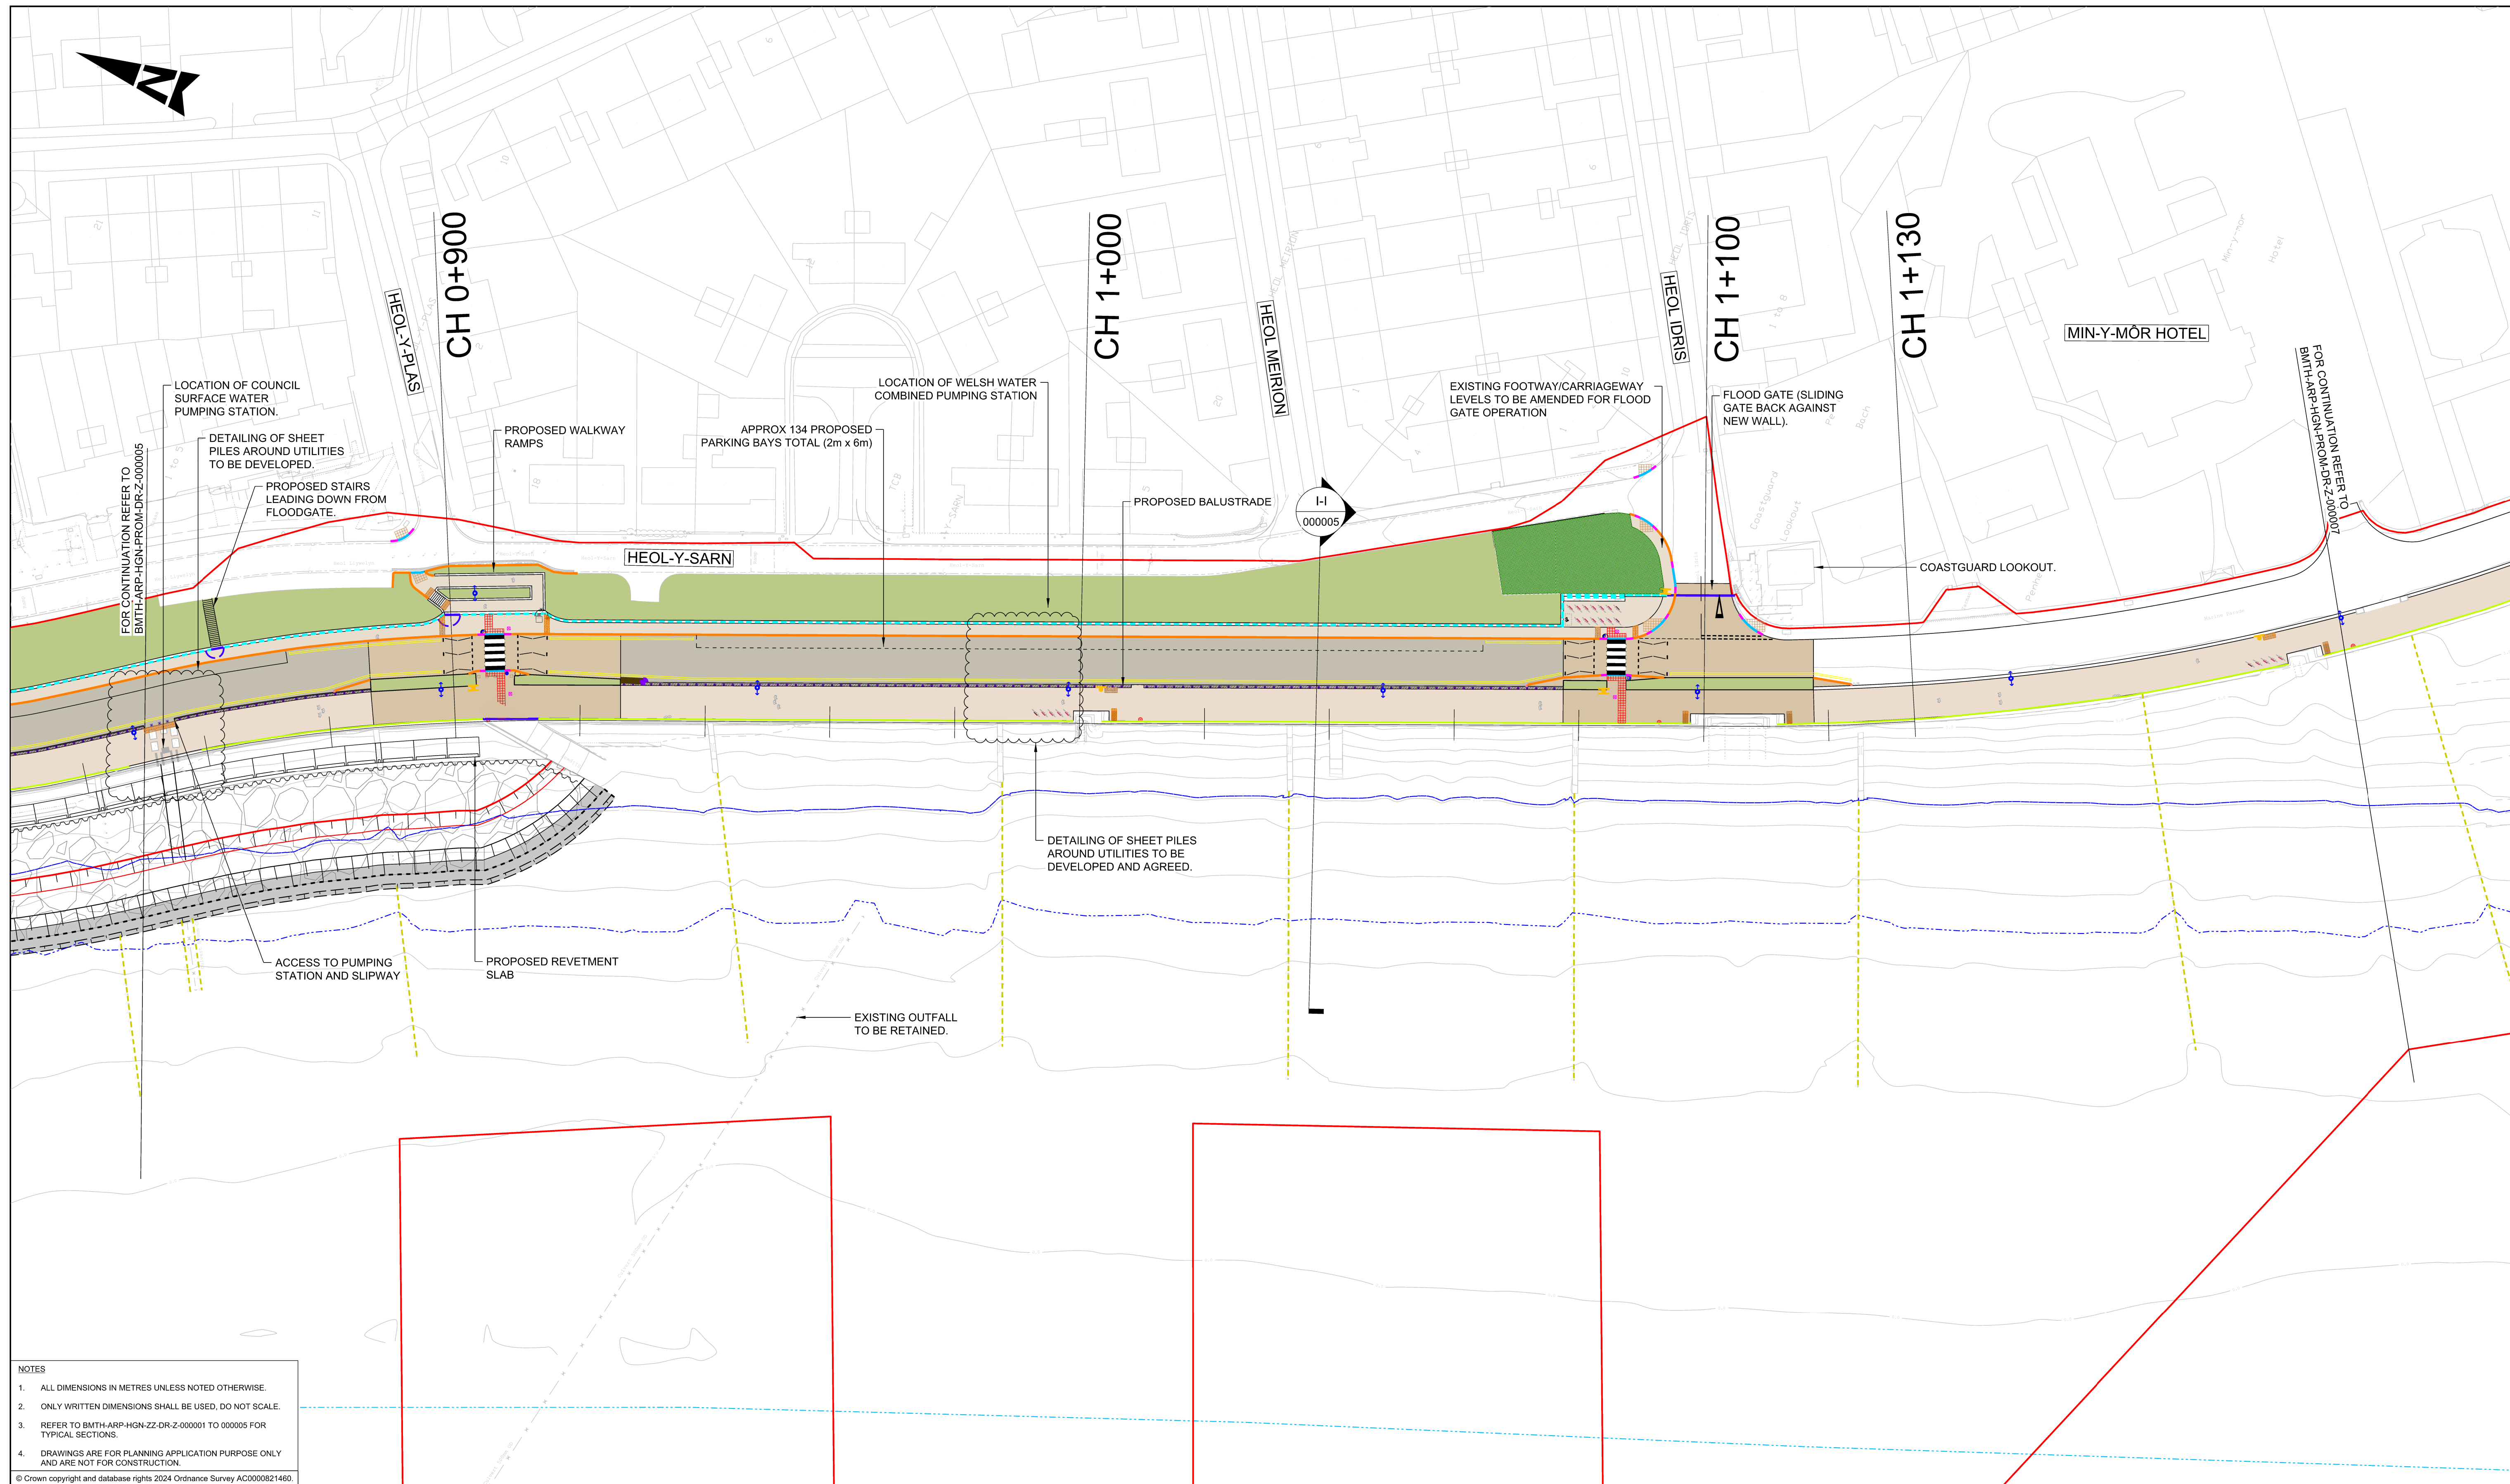 


- NOTES
- ALL DIMENSIONS IN METRES UNLESS NOTED OTHERWISE.
 - ONLY WRITTEN DIMENSIONS SHALL BE USED, DO NOT SCALE.
 - REFER TO BMTH-ARP-HGN-ZZ-DR-Z-000001 TO 000005 FOR TYPICAL SECTIONS.
 - DRAWINGS ARE FOR PLANNING APPLICATION PURPOSE ONLY AND ARE NOT FOR CONSTRUCTION.
- © Crown copyright and database rights 2024 Ordnance Survey AC0000821460.

LEGEND	
	CAR PARK
	ROAD
	FOOTWAY/PROMENADE SURFACE
	GRASS CONCRETE PAVING SYSTEM
	TRAFFIC SIGN
	RED LINE BOUNDARY (FOR EIA AND PLANNING)
	HALF BATTERED KERB - TYPE HB2
	BULLNOSE CROSSING KERB - TYPE BN
	HALF BATTERED DROPPER KERB - TYPE HBD
	WIDE TOP KERB
	TRIEF KERB
	TRIEF QUADRANT KERB
	HB QUADRANT KERB
	PROPOSED BALUSTRADE
	ROCK ARMOUR
	EDGE OF LEVEL SECTION
	TOE OF 1:3 EMBANKMENT
	EDGE OF SECONDARY LEVEL SECTION
	TOE OF 1:1.5 EMBANKMENT 1.22m BELOW BEACH LEVEL
	STRUCTURAL ELEMENTS BURIED BELOW EXISTING BEACH LEVEL
	RETAINED PRIMARY WALL
	PROPOSED SECONDARY WALL
	FLOOD GATE (PROPOSED) - TO BE CLOSED DURING STORM EVENT
	DIRECTION OF FLOOD GATE
	PROPOSED SHEET PILES TO BE INSTALLED IN FRONT OF EXISTING (SEA SIDE).
	ROAD LIGHTING CHAMBER
	GROYNES TO BE REMOVED
	MEAN HIGH WATER SPRINGS 2.65m OD
	MEAN HIGH WATER NEAPS 1.26m OD
	MEAN LOW WATER NEAPS -0.54m OD
	MEAN LOW WATER SPRINGS -1.74m OD
	SE1 - BENCH
	SE2 - LOUNGER
	SE3 - SEAT
	SE4 - PICNIC SET
	SE5 - MULTILEVEL LINEAR STRUCTURE
	LC - LIGHTING COLUMN
	SP1 - RAISED CONCRETE PLANTER
	SP2 - RAISED METAL PLANTER
	SW1 - PLANTING AREAS
	CS1 - CYCLE STAND
	CS2 - CYCLE STAND WITH TAPPING PLATE
	BO1 - BOLLARD FIXED
	BO2 - BOLLARD DEMOUNTABLE
	TACTILES

SAFETY, HEALTH AND ENVIRONMENTAL INFORMATION	
IN ADDITION TO THE HAZARDS/RISKS NORMALLY ASSOCIATED WITH THE TYPES OF WORK DETAILED ON THIS DRAWING, NOTE THE FOLLOWING SIGNIFICANT RESIDUAL RISKS (REFERENCE SHALL ALSO BE MADE TO THE DESIGN HAZARD LOG).	
CONSTRUCTION	N/A
MAINTENANCE / CLEANING	N/A
USE	N/A
DECOMMISSIONING / DEMOLITION	N/A

Rev.	Date	Description	By	Chk'd	App'd	Auth'd
P01	10/06/25	LAYOUT TO COMMENCE EIA	ES	PS	TE	
P02	28/07/25	ISSUE FOR EIA AND COSTING REVIEW	KD	LM	TE	
P03	11/09/25	FOR PRE APPLICATION CONSULTATION	ES	LM	TE	
P04	02/10/25	UPDATED TO SHOW REMOVED GROYNES	ES	PS	TE	
P05	12/03/26	ISSUE FOR PLANNING	KD	PS	TE	
P06	15/05/26	ISSUE FOR PLANNING	ES	LM	PS	

Suitability		Drawing Status		Project Title				
S4		Suitable for review and authorization		BARMOUTH NORTH PROMENADE FAS				
GRIFFITHS ARUP				Drawing Title				
				OUTLINE DESIGN LAYOUTS GENERAL ARRANGEMENT SHEET 4 OF 5				
Client  YGC  Llywodraeth Cymru Welsh Government				Scale	By	Checked	Approved	Authorised
				1:500	ES	LM	PS	
				Original Size	Date	Date	Date	Date
A1	15/05/26	15/05/26	15/05/26					
Drawing Number				Revision				
Project		Originator		Volume				
BMTH		ARP		HGN				
XXXX		- DR - Z		- 000006				
Location		Type Role Number						