


BRYN CEMLYN WDRD

INTAKE DRAWING - AS BUILT V.2

ALL DIMENSIONS IN MM.

Impoundment

Scale: 1:25

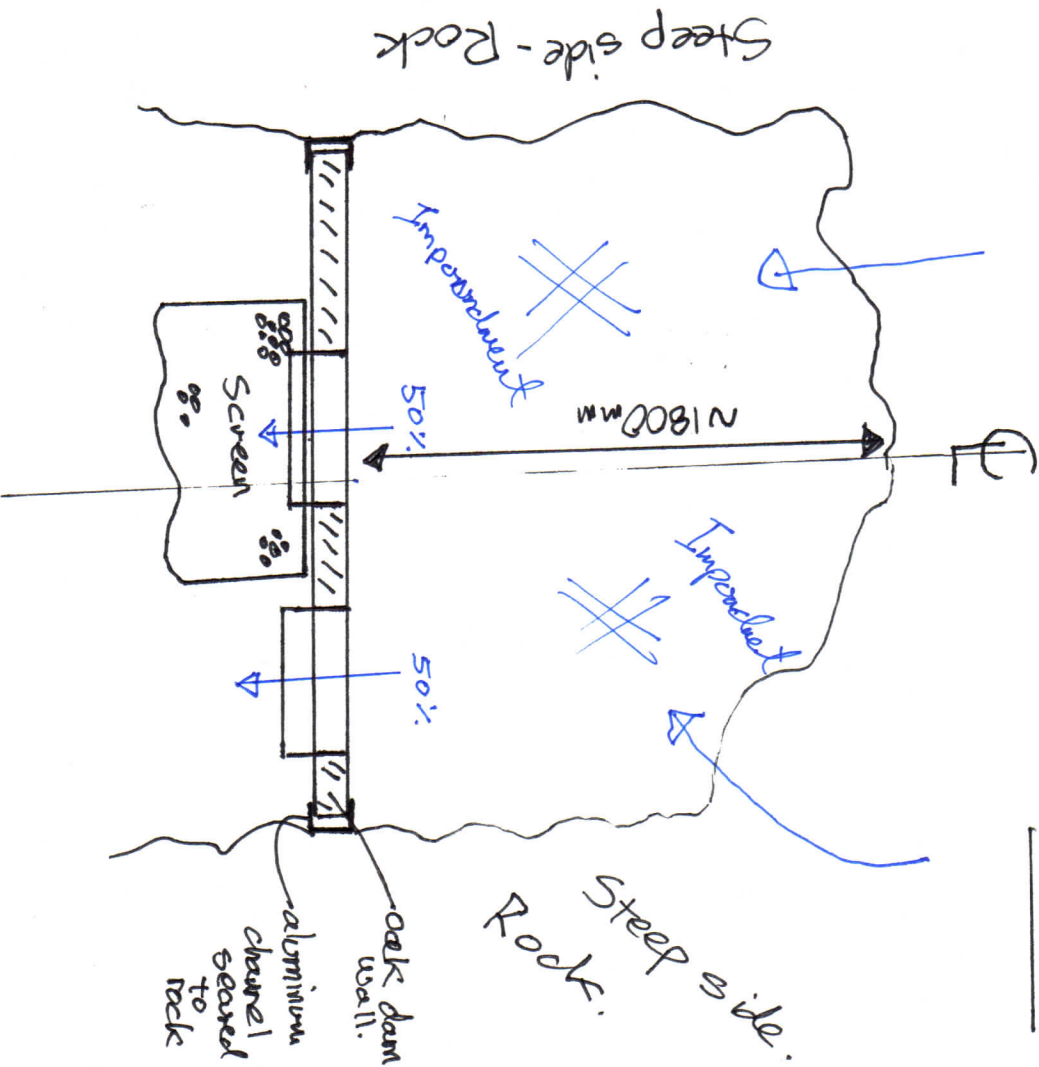

Scale = 1:25

2200mm

660mm

500

360

500

180

82.9m AOD

82.9m AOD

Rock

Wood

Screen

QAS

40mm ϕ

284

100

DISTANCE OF HOF PILE BELOW WEIR CREST

100mm

Rock

Aluminium channel. secured to rock.

Rock

