


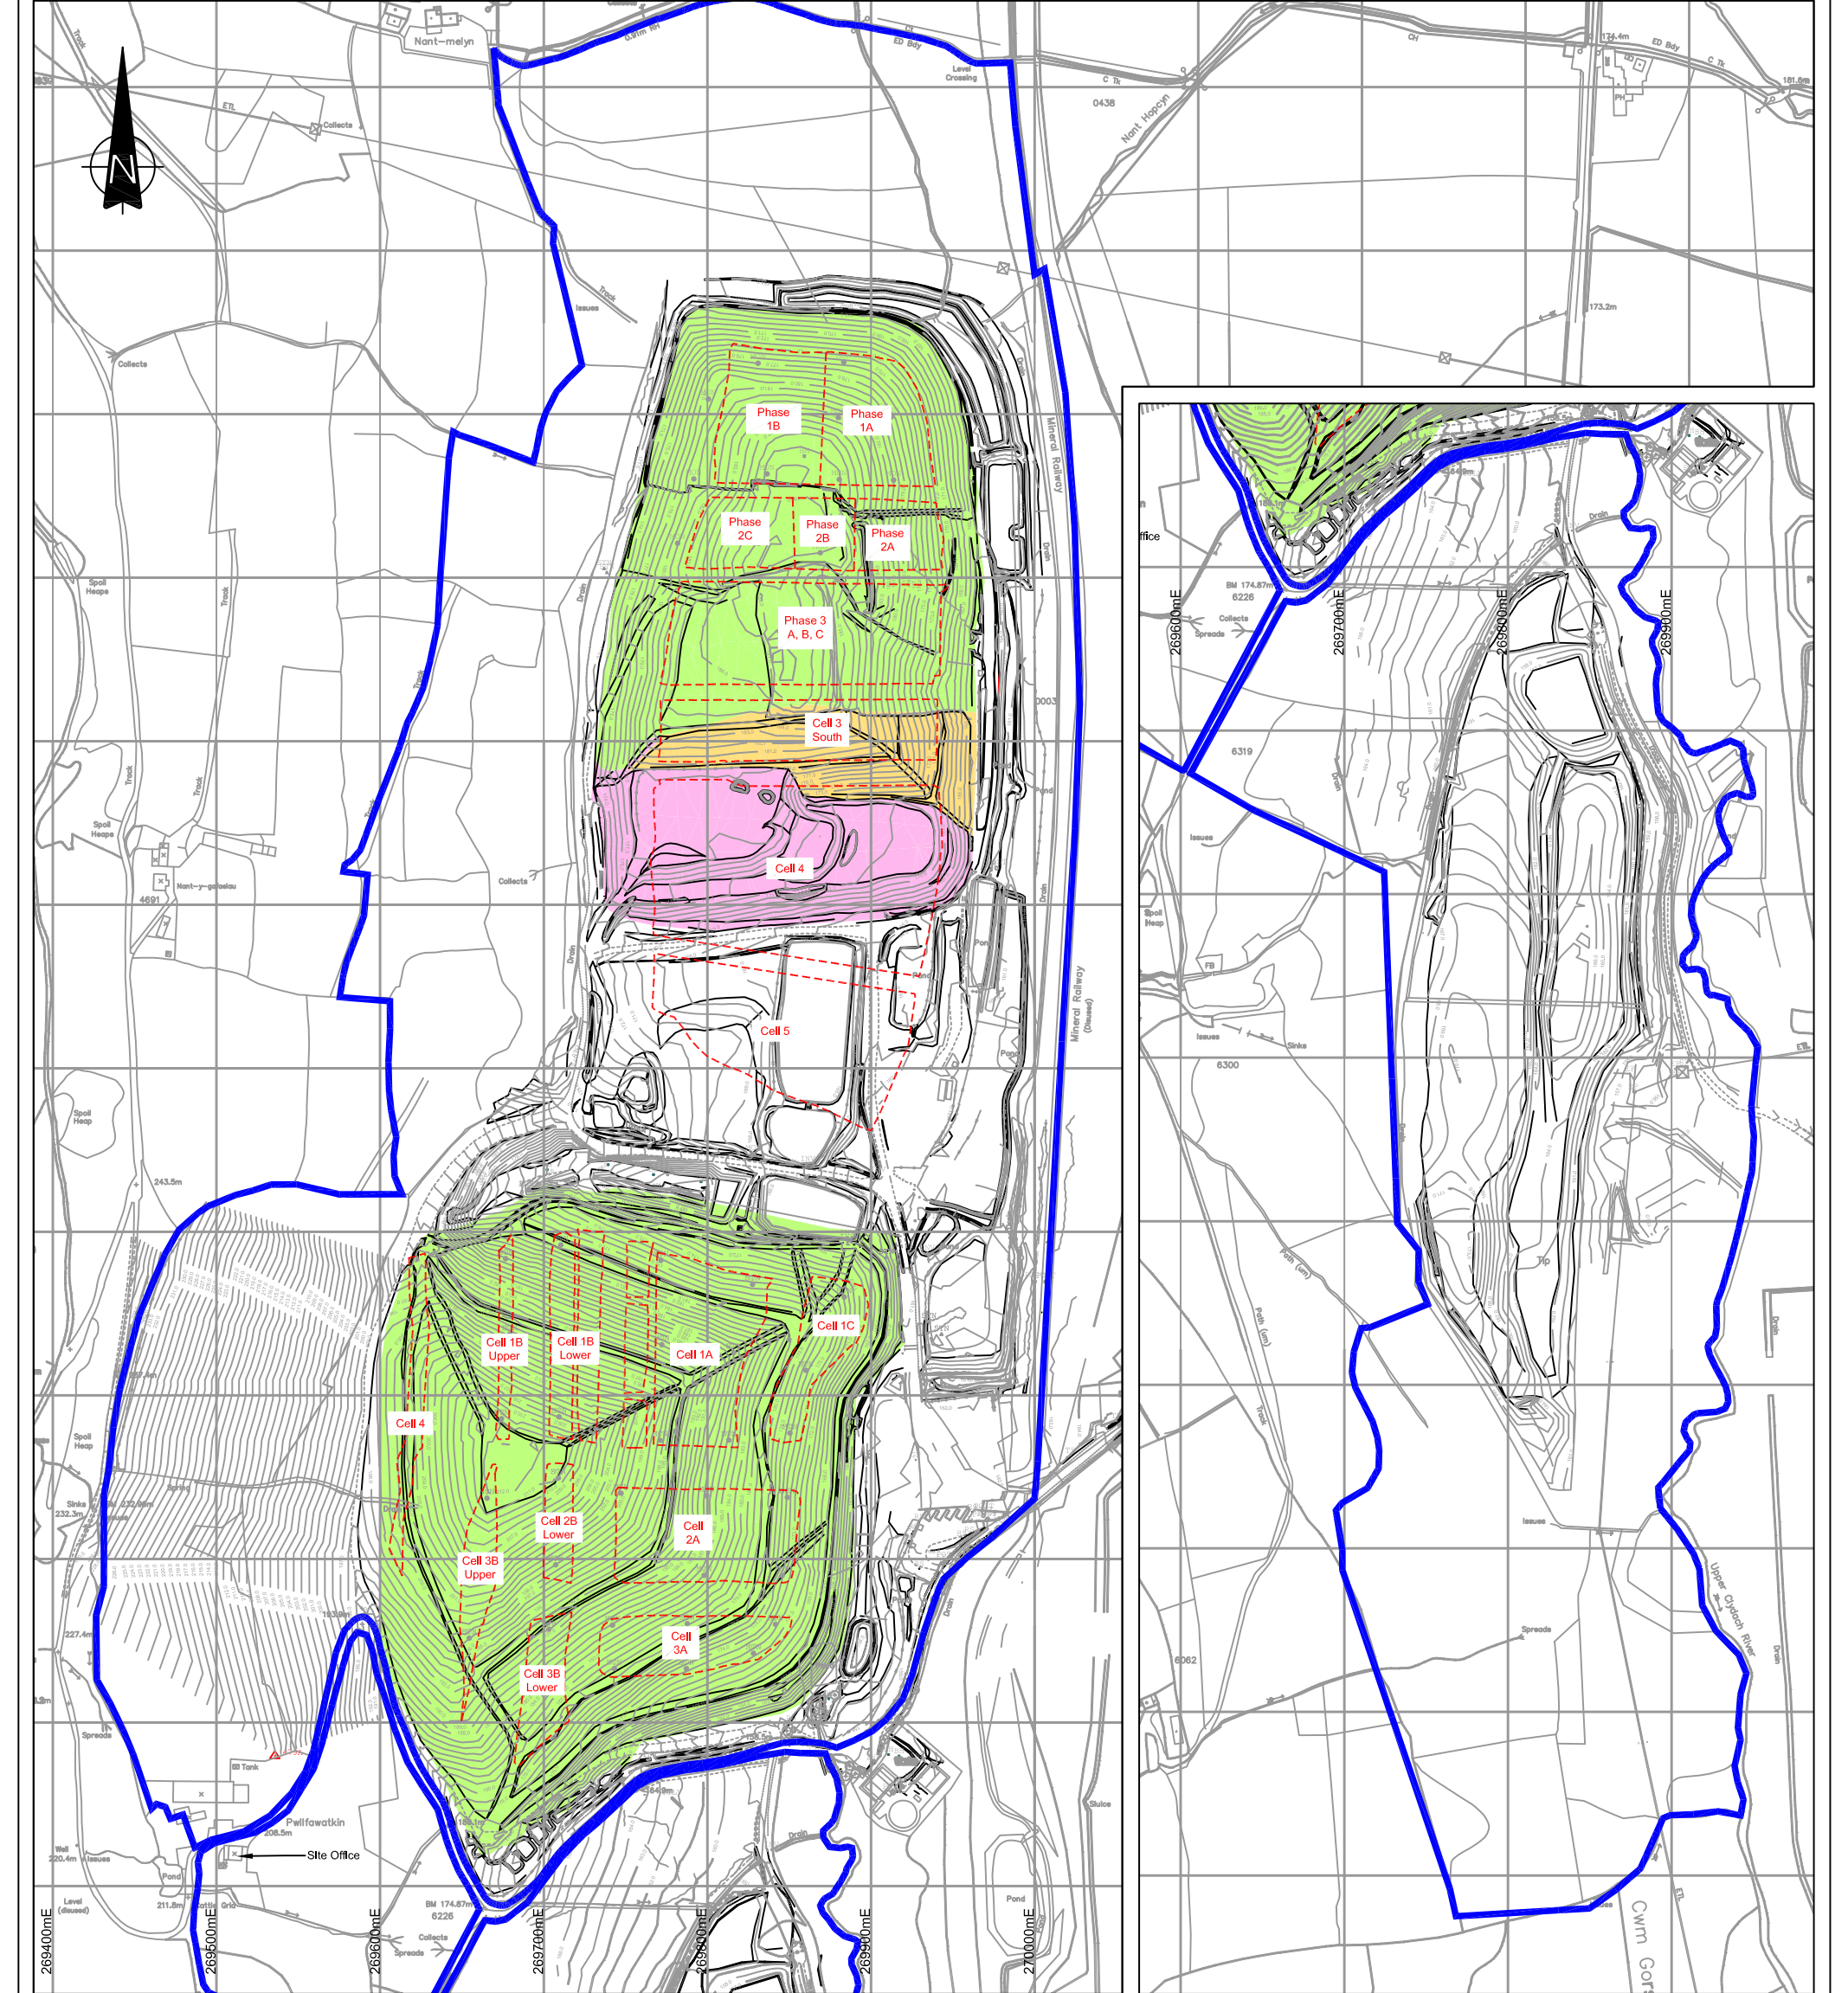

LEGEND:

Ownership Boundary

Open Waste Area

Proposed Area

Temporary Capped Area

Permanently Capped

Construction Area

Latest Available Ground Contours

As-built Cell Footprint

NOTES:

1. ALL DIMENSIONS IN MILLIMETRES AND ALL LEVELS IN METRES ABOVE ORDNANCE DATUM.

2. DO NOT SCALE FROM THIS DRAWING.

3. ANY ANOMALIES IDENTIFIED WITH THE DETAILS SHOWN ON THIS DRAWING ARE TO BE BROUGHT TO THE ATTENTION OF FCC ENVIRONMENT (UK) LIMITED PRIOR TO CONSTRUCTION WORKS COMMENCING.

Revision	Date	Description	By	Chk
-	-	-	-	-
-	-	-	-	-
-	-	-	-	-

Reference files:
Information taken from plans;
Site Survey: 479W2329
Area Models: 479A2333

Reproduced from Ordnance Survey Digital maps with the permission of the Controller of Her Majesty's Stationery Office. © Crown copyright. FCC Environment (UK) Limited, 6 Siddings Court, White Rose Way, DONCASTER DN4 5NU, Licence No 0100031673

FCC

Environment

FCC Environment (UK) Limited
6 Siddings Court, White Rose Way, Doncaster. DN4 5NU

Site:
**PWLLFAWATKIN
LANDFILL SITE**

Drawing Title:
**Annual Site Plan
2019**

Drawn By: BS	Checked By: LH	Date: 07.01.19	Scale: 1:4000	Paper Size: A3
Status: FINAL	Revision: -	Drawing No: 479A439	Plan Number: PLAN 2	

Unit: Scale: 1:4000 Date: 4-Jan-19 Plot: By: Ben Stokes