


Sling, Llangristiolus, Bodorgan**From:** Bailey Dafydd <Dafydd.Bailey@dwrcymru.com>**To:** kriselize@aol.com <kriselize@aol.com>**Date:** Fri, 26 Jul 2019 17:33

CW S 124147

Good afternoon,

Thank you for your enquiry.

Having reviewed our mapping records, the nearest foul sewer is located approximately 213m from Sling.

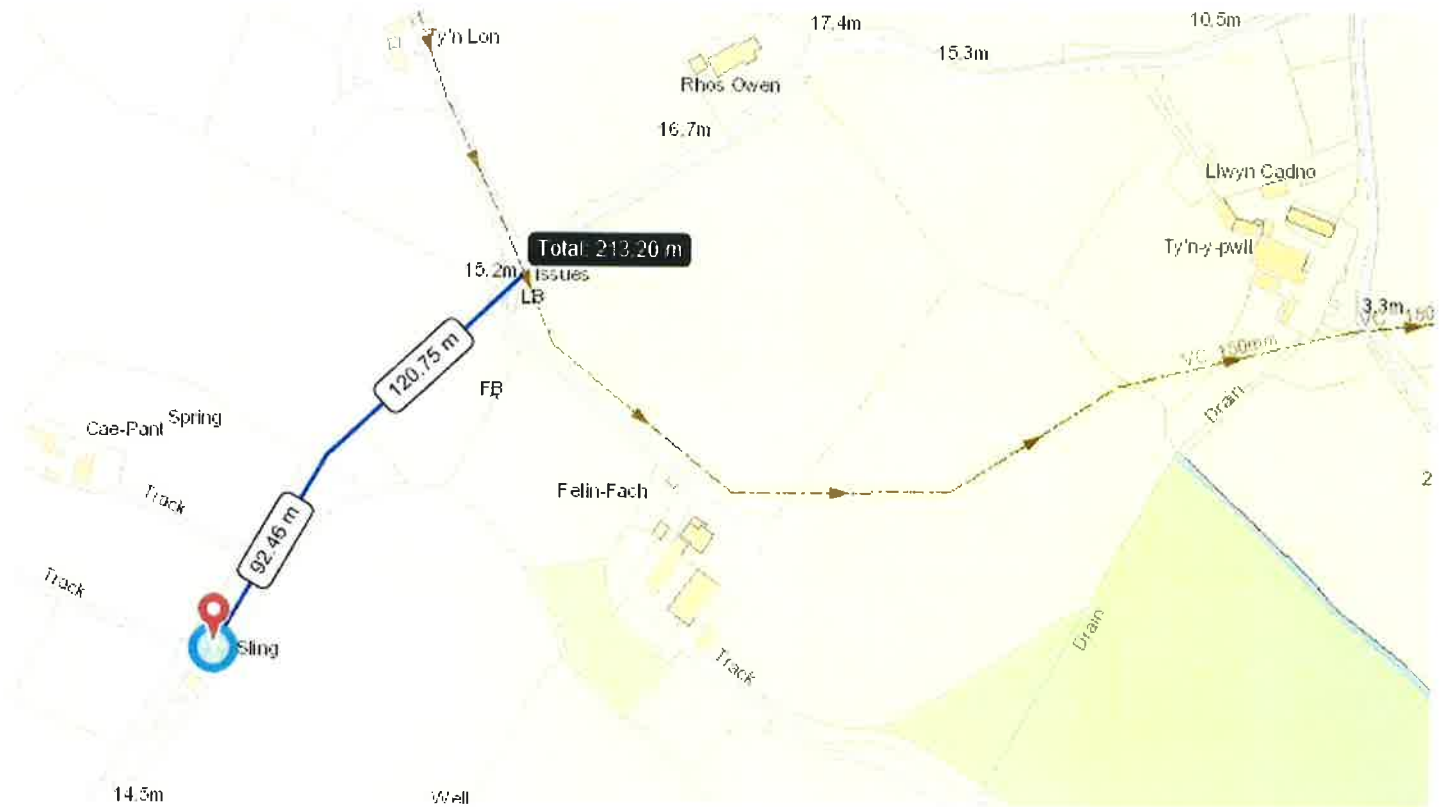

I hope the above is of assistance.


Kind regards,
Dafydd**Dafydd Bailey****Development Control Officer | Developer Services | Wholesale Business Services |
Services Dwr Cymru Welsh Water**Kinmel Park | Bodelwyddan | LL18 5TQ | T: 0800 917 2652 | www.dwrcymru.com

Dwr Cymru Welsh Water is firmly committed to water conservat efficiency. Please log on to our website www.dwrcymru.com/waterefficiency to find out how you can become water wise. Mae Dwr Cymrwym ymro y warchod adnoddau dwr a hyrwyddo defnydd dwr effeithiol. Mae cyngor i' ch helpu i ddefnyddio dwr yn ddoeth yn www.dwr

attached is confidential. If you are not a named recipient or believe you may have received this email in error please delete from your inform the sender. Dwr Cymru Cyf (trading as Welsh Water) is a company registered in England and Wales, number 02366777, regist Nelson, Treharris, Mid Glamorgan CF46 6LY. Mae'r neges e-bost yma ac unrhyw ffeil sydd ynghlwm wrthi'n gyfrinachol. Os nad chi yv neu os ydych chi'n credu eich bod wedi derbyn y neges yma ar gam, dylech ei dileu o'ch system ar unwaith a hysbysu'r anfonwr. Cwr yng Nghymru yw Dŵr Cymru Cyf (yn masnachu fel Dŵr Cymru), ei rif cofrestredig yw 02366777, ac mae ei swyddfa gofrestredig yn H Treharris, Morgannwg Ganol CF46 6LY.

CUS124147

Sling, Road From Junction Near Capel Farm Past Nant Yr Odyn To A5 T, Bodorgan, LL62 5RD

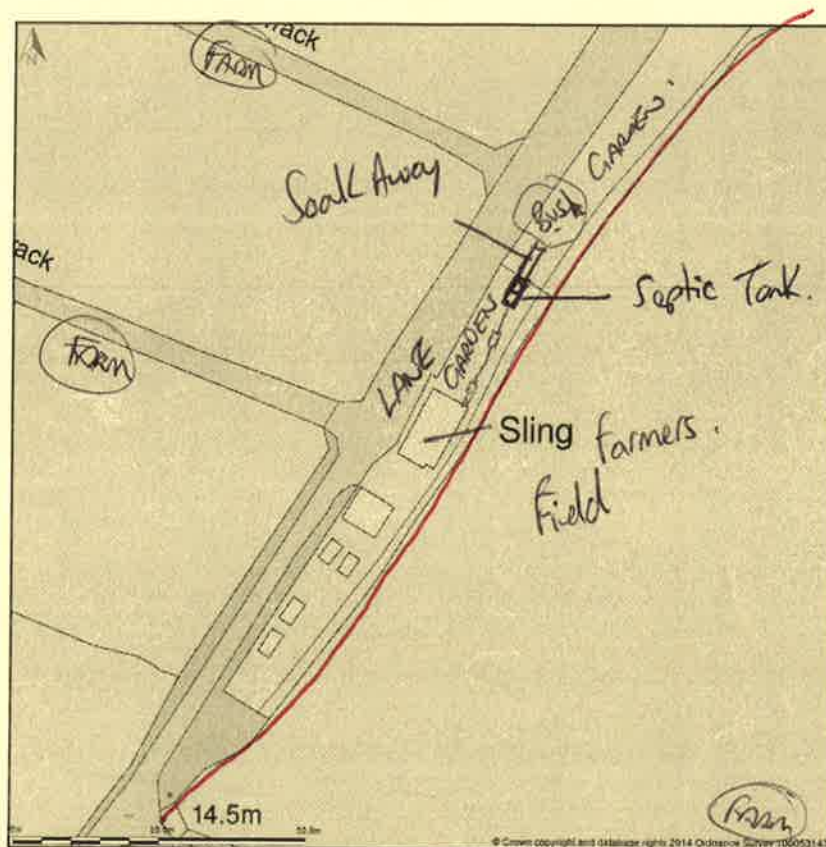

Site Plan shows area bounded by: 243682.2893,372704.2893 243823.7107,372845.7107 (at a scale of 1:1250) The representation of a road, track or path is no evidence of a right of way. The representation of features as lines is no evidence of a property boundary.

Produced on 3rd May 2014 from the Ordnance Survey National Geographic Database and incorporating surveyed revision available at this date. Reproduction in whole or part is prohibited without the prior permission of Ordnance Survey. © Crown copyright 2014. Supplied by buyaplan.co.uk a licensed Ordnance Survey partner (100053143). Unique plan reference: #00033642-D00BE1

Ordnance Survey and the OS Symbol are registered trademarks of Ordnance Survey, the national mapping agency of Great Britain. Buy A Plan logo, pdf design and the buyaplan.co.uk website are Copyright © Pass Inc Ltd 2014

Red Line - run off stream.

Dry in summer

Runs off fields and hills in winter.