


APPENDIX 1
AS-BUILT DRAWING

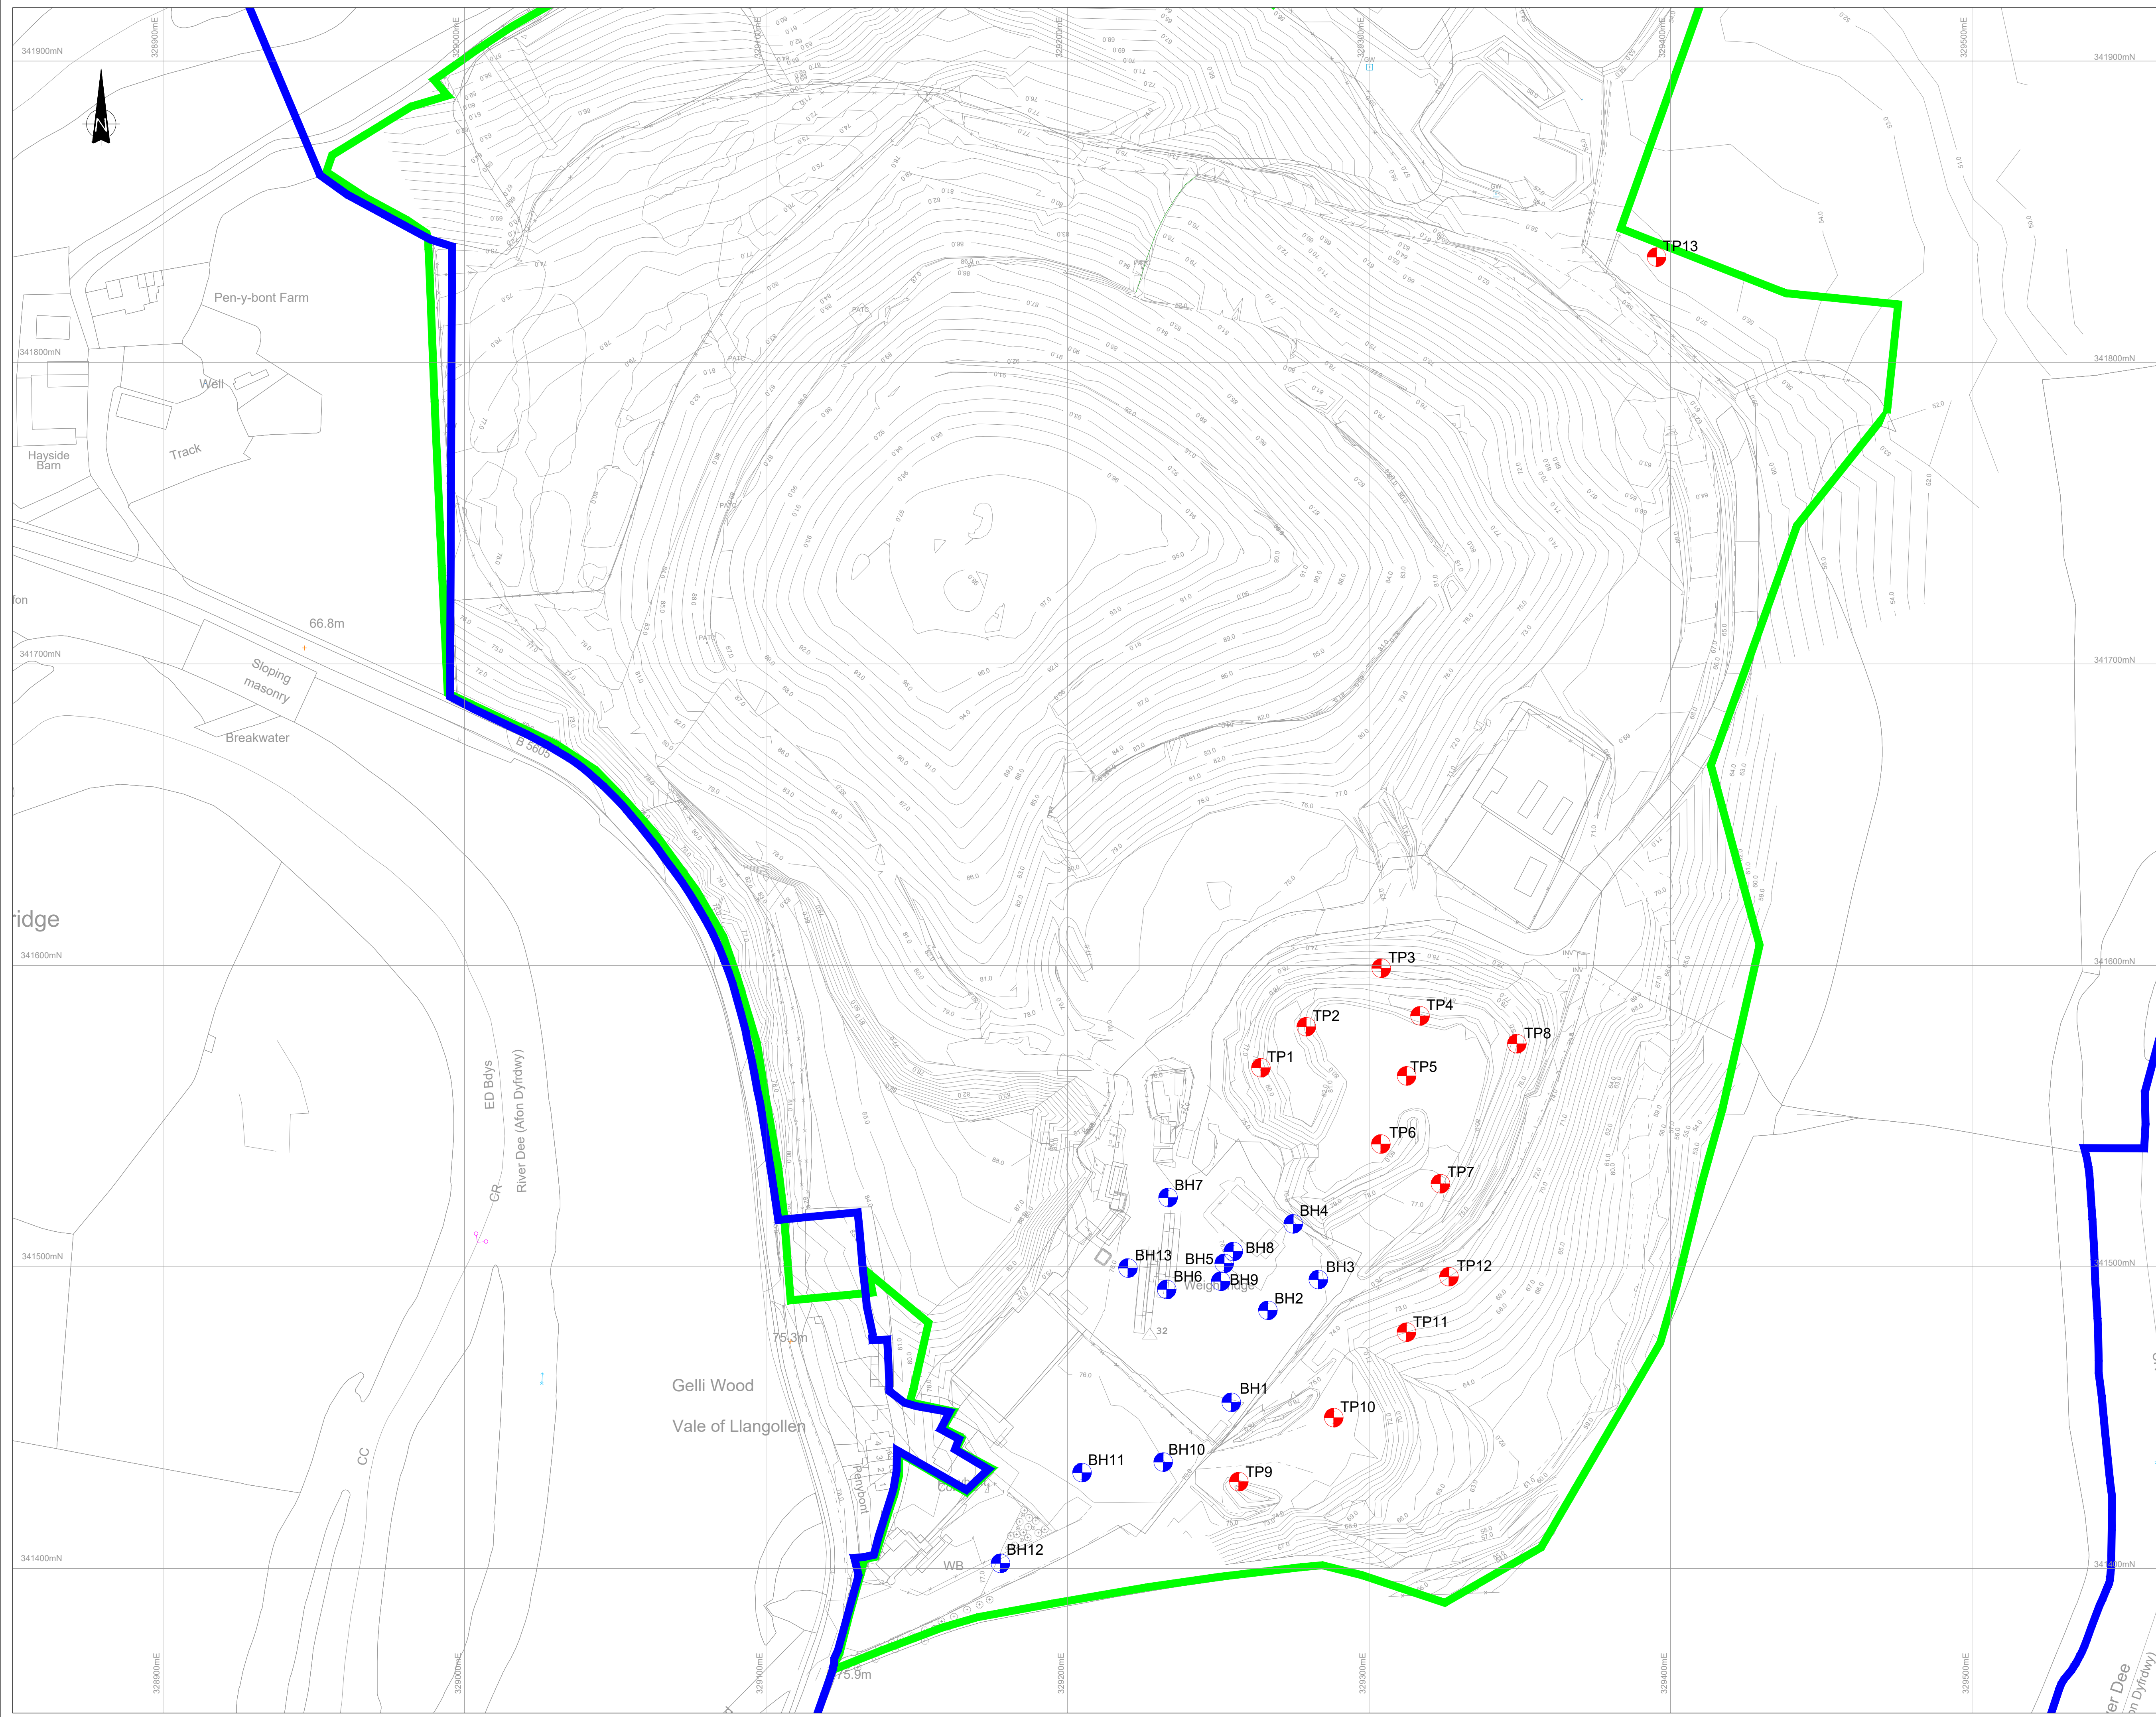

THIS INFORMATION IS CONFIDENTIAL AND THE PROPERTY OF SIRIUS. IT IS RELEASED ON CONDITION THAT NONE OF THE INFORMATION SHALL BE DISCLOSED TO ANY THIRD PARTY OR REPRODUCED IN WHOLE OR PART WITHOUT THE PRIOR CONSENT IN WRITING OF SIRIUS.

NOTES

- ALL LEVELS TO mAOD
- DO NOT SCALE FROM THIS DRAWING
- BACKGROUND SURVEY INFORMATION SUPPLIED BY FCC ENVIRONMENT (UK) LTD


KEY

TP1 TRIAL PIT LOCATIONS

BH1 BOREHOLE LOCATIONS

REV	DESCRIPTION	DATE	BY

CLIENT



JOB TITLE

PEN-Y-BONT LANDFILL PART SURRENDER APPLICATION

DRAWING TITLE

BOREHOLE AND TRIAL PIT LOCATIONS

DRAWN	DATE	APPROVED	DATE
J.D	03/07/2018	M.K	03/07/2018

SCALE	SHEET	DRAWING NUMBER	REVISION
1:1000	A1	WR7449/6/001	0