



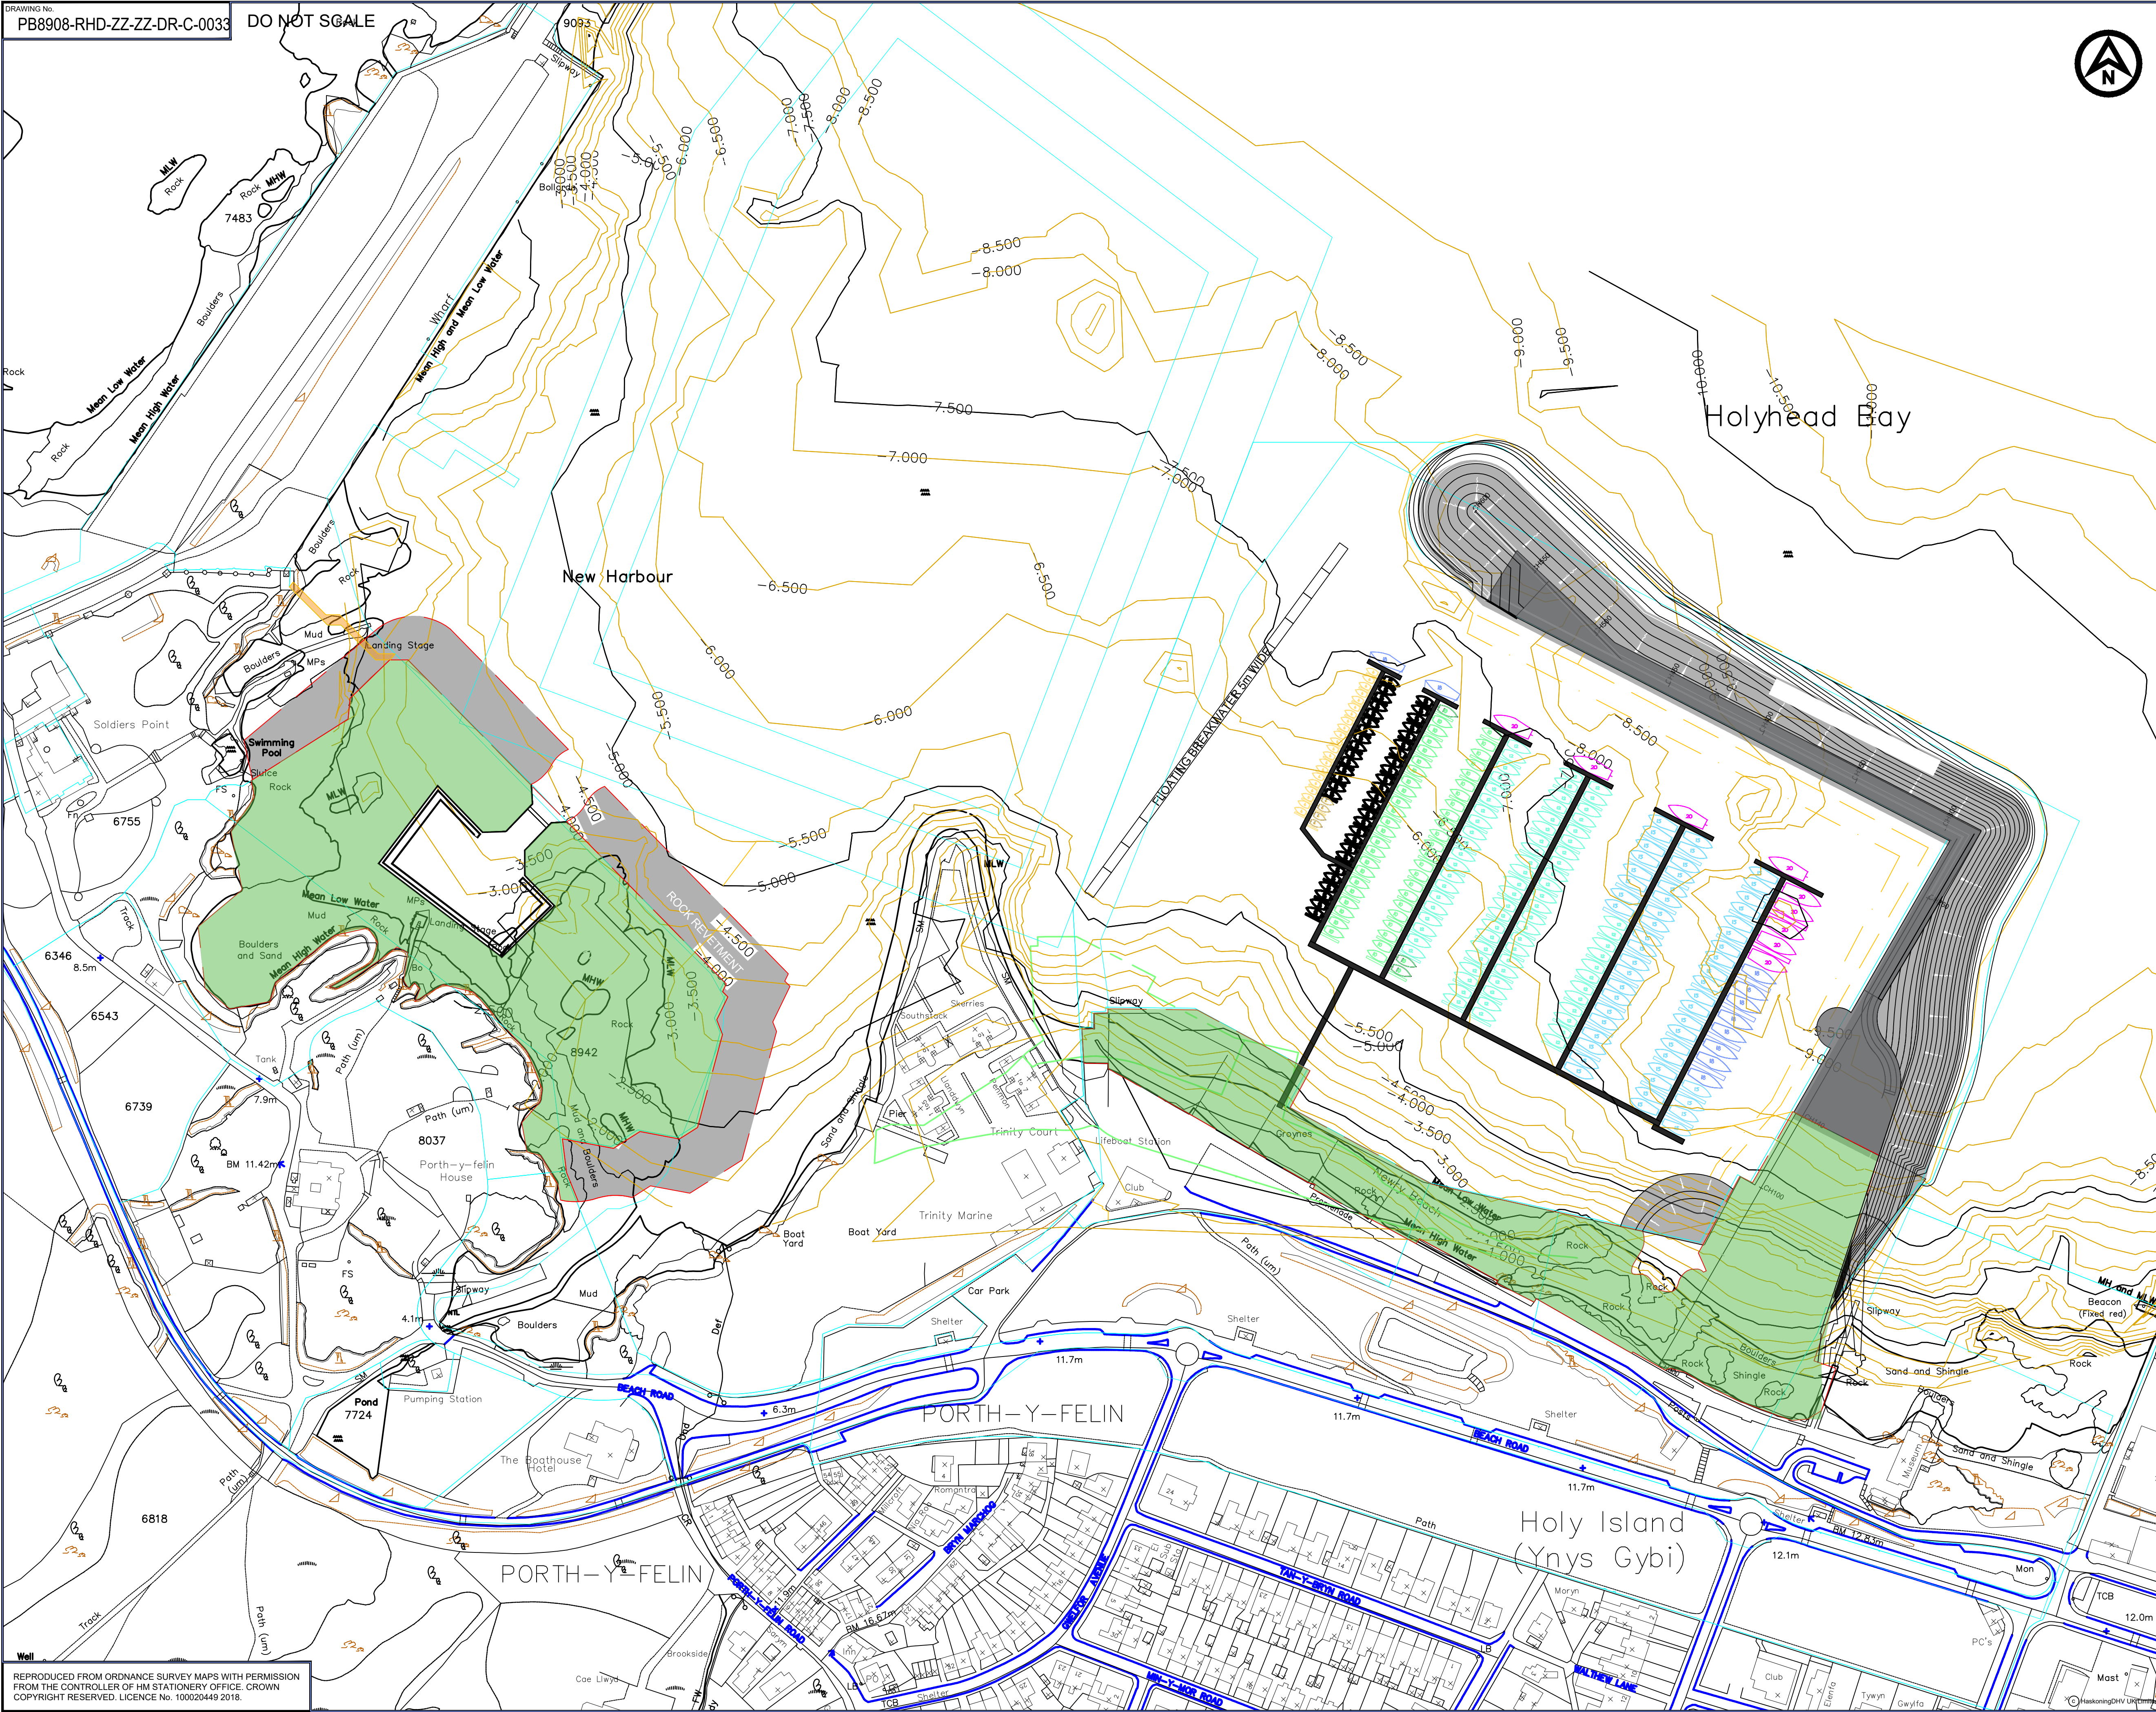

NOTES

- ALL DIMENSIONS ARE IN MILLIMETRES UNLESS NOTED OTHERWISE.
- ALL LEVELS ARE IN METRES RELATIVE TO ORDNANCE DATUM NEWLYN (mOD). FOR RELATIONSHIP BETWEEN ORDNANCE DATUM AND CHART DATUM REFER TO DIAGRAM BELOW
- CONTOURS ARE IN METERS RELATIVE TO ORDNANCE DATUM (OD).

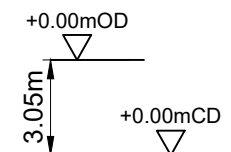

KEY

VB-00 AS-BUILT VIBROCORE LOCATIONS

VESSEL KEY

- 20m LENGTH
- 18m LENGTH
- 15m LENGTH
- 12m LENGTH
- 10m LENGTH
- 8m LENGTH
- 6m LENGTH

TIDAL INFORMATION		
STATE OF TIDE	LEVEL (mCD)	LEVEL (mOD)
HIGHEST ASTRONOMICAL TIDE (HAT)	+6.30	+3.25
MEAN HIGH WATER SPRINGS (MHWS)	+5.60	+2.55
MEAN HIGH WATER NEAPS (MHWN)	+4.40	+1.35
MEAN SEA LEVEL (MSL)	+3.27	+0.22
MEAN LOW WATER NEAPS (MLWN)	+2.00	-1.05
MEAN LOW WATER SPRINGS (MLWS)	+0.70	-2.35
LOWEST ASTRONOMICAL TIDE	+0.00	-3.05

P01	09.03.21	ISSUED FOR REVIEW	RA	GT	NC
REV	DATE	DESCRIPTION	BY	CHK	APP

REVISIONS

CLIENT



PROJECT
HOLYHEAD WATERFRONT DEVELOPMENT

TITLE

MARINA LAYOUT



DRAWN	RA	CHECKED	GT	APPROVED	NC
DATE	MAR'21	SCALE	1:1500	REF.	
DRAWING No.	PB8908-RHD-ZZ-ZZ-DR-C-0033	SUITABILITY	S2	REVISION	P01