


REAR ELEVATION.

SIDE ELEVATION.

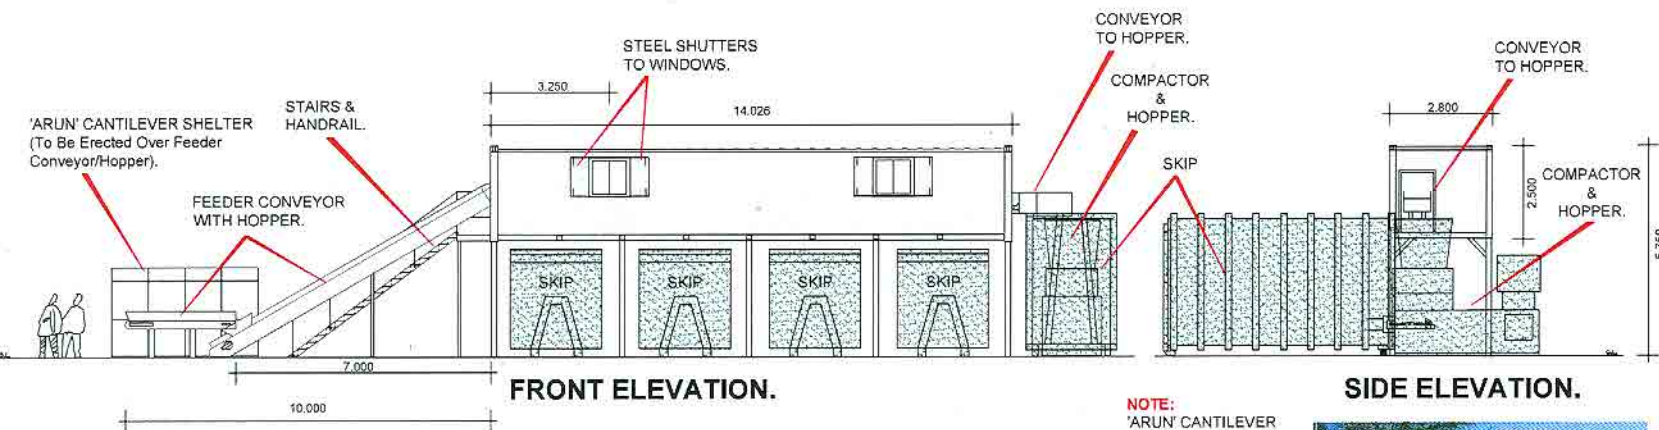

FRONT ELEVATION.

SIDE ELEVATION.

'ARUN' CANTILEVER SHELTER (To Be Erected Over Feeder Conveyor/Hopper).




TYPICAL IMAGE OF SHELTER.

**NOTE:**  
'ARUN' CANTILEVER SHELTER.  
(To Be Erected Over Feeder Conveyor/Hopper).



IMAGE: AS BUILT (TO DATE).

**NOTE:**  
FINISHED COLOUR TO SHELTER, CABIN, WINDOW SHUTTERS & DOOR:  
RAL No. 00A05.  
CONVEYOR/HOPPER, STAIRS, HANDRAILING & SUPPORT LEGS ETC:  
GANVANISED FINISH.

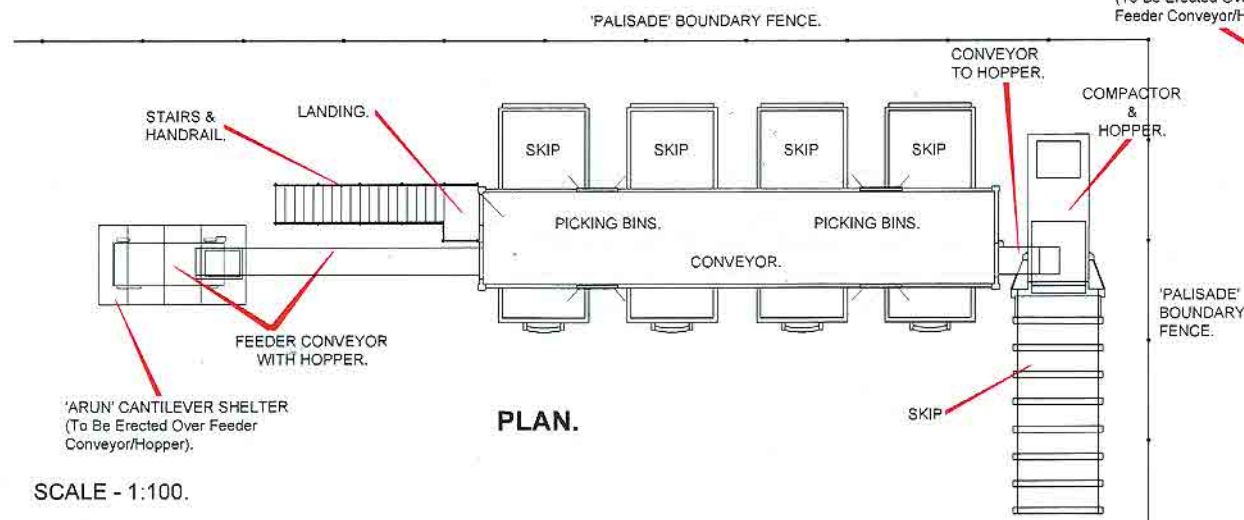

PLAN.

SCALE - 1:100.

**HOUSEHOLD WASTE RECYCLING CENTRE - CLYNE.**  
Picking Station: Retention & Completion.  
As Built & Proposed Shelter.

Phil Roberts  
Director of Place - Cylarwyddwr Lleoliad  
Landscape Team - Tîm Tirllysia

Civic Centre, Swansea SA1 3SN  
Conolfen Ddaesig, Abertawe SA1 3SN  
Telephone / Teleffon : (01792) 635752  
Facsimile / Ffacsmitl : (01792) 635719  
Minicom : (01792) 635708

<http://www.swansea.gov.uk>

Date / Dyddiad : November 2013  
Drawn By / Dylunwyd gan : AJP  
Checked / Archwilywyd gan : x  
Scale / Graddfa : 1:100.  
Drawing No / Rhif Cynllun : P/L749/13/08/01

