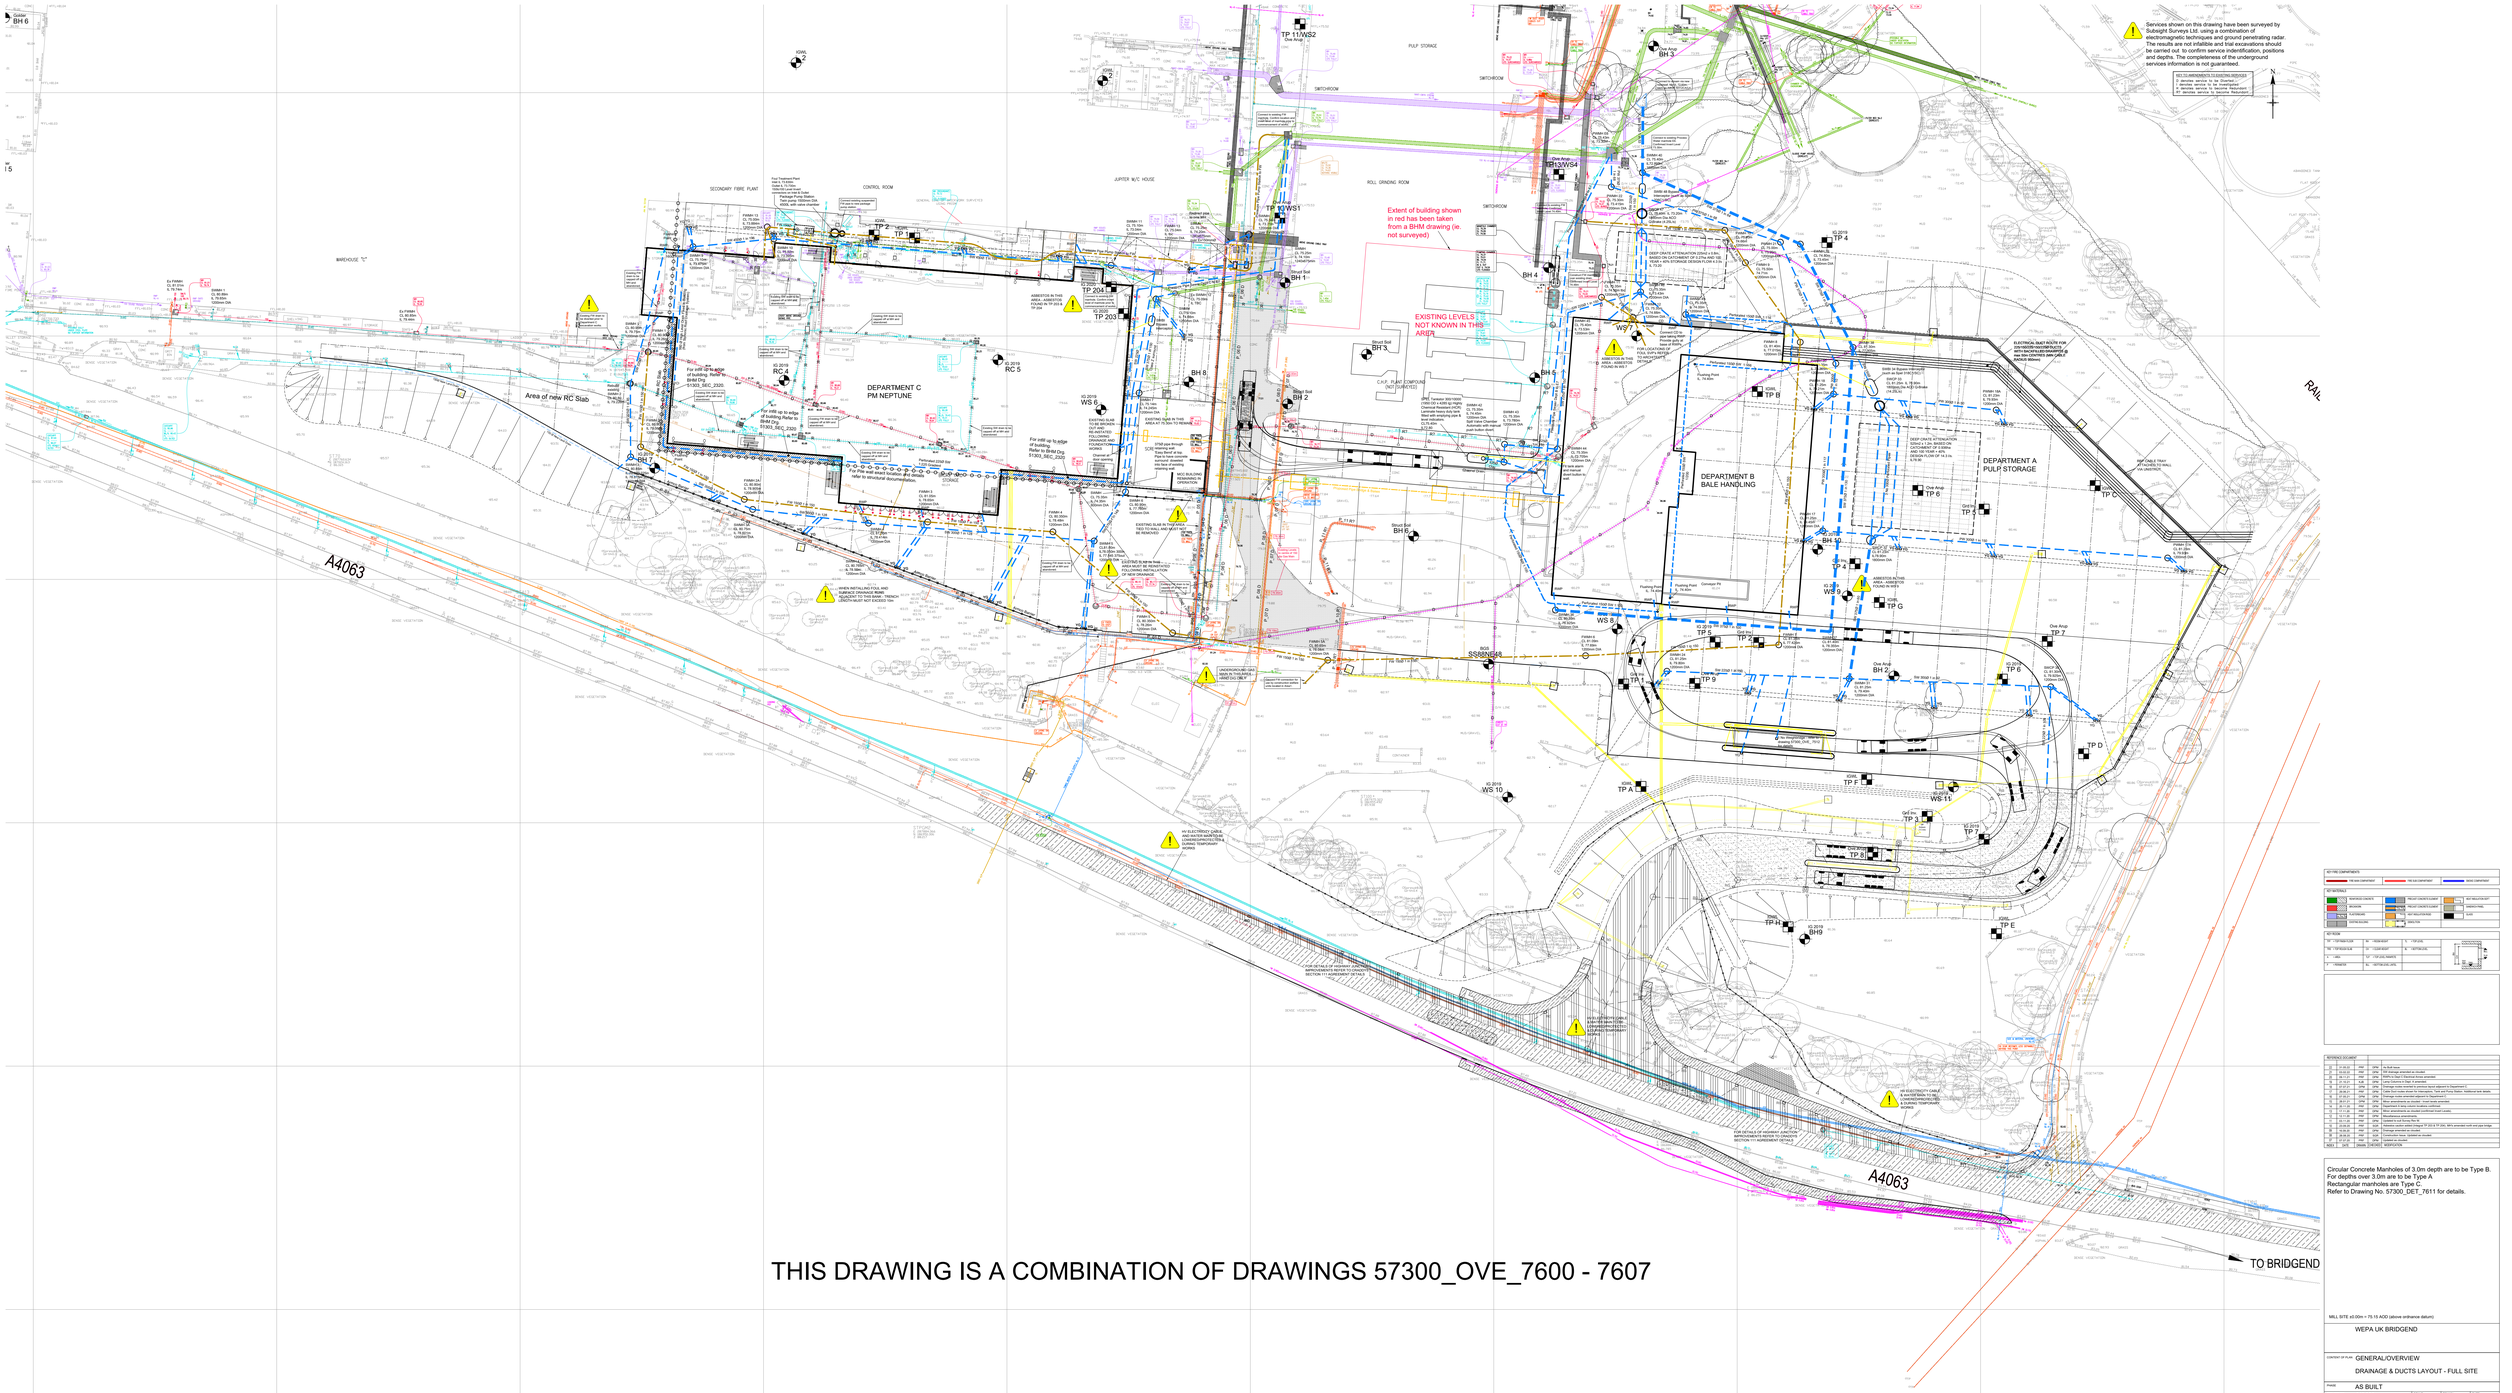

Circular Concrete Manholes of 3.0m depth are to be Type B.
For depths over 3.0m are to be Type A
Rectangular manholes are Type C
Refer to Drawing No. 57300_DET_7611 for details.

MILL SITE ±0.00m = 75.15 AOD (above ordnance datum)

WEPA UK BRIDGEND

CONTENT OF PLAN: GENERAL/OVERVIEW

DRAINAGE & DUCTS LAYOUT - FULL SITE

Status:	AS BUILT		
PROJECT No: 119003	SCALE: NTS	Drawn: PMF	DATE: 18.09.2020
PLAN No: 57300_OVE_7615	SHEET: 01	CHECKED: MR	
PLAN REV: D01		APP'D: DPR	

