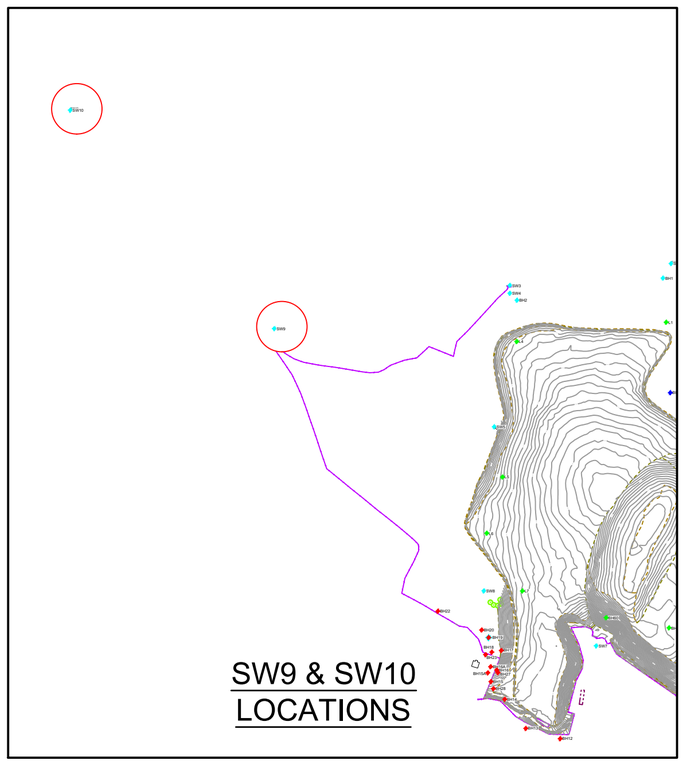

PLEASE NOTE
Water Monitoring Locations BH96B, SW9 and SW10 are located to the south of the site and the As-built co-ordinates can be found in the adjacent table.

NOTES

1. All Survey information provided by Egniol Environmental Ltd.
2. All dimensions in millimetres and all levels in metres above ordnance datum.
3. Do not scale from this drawing.
4. Any anomalies on this drawing should be brought to the attention of Egniol Environmental Ltd.

Key

- 6.0 — Topographical Contours
- BH9 — Surface Water Monitoring Point
- BH9 — Ground water Monitoring Point
- BH9 — Leachate well
- BH9 — Gas well
- Fence Line
- Top of Batter
- Bottom of Batter

All Monitoring Borehole and Water Sample Locations are to Local Grid Co-ordinates.

Gas Monitoring Borehole Locations

Borehole I.D.'s	Easting	Northing
BH1	5157.906	5303.375
BH2	5228.768	5380.112
BH3	5279.349	5439.864
BH4	5318.808	5492.211
BH5	5407.673	5432.536
BH6	5485.657	5388.465
BH7	5578.167	5358.108
BH9	5792.651	5357.339
BH10	5750.574	5276.982
BH11	5716.254	5201.142
BH12	5680.675	5136.870
BH13	5666.004	5085.401
BH14	5621.109	5053.065
BH15	5594.390	5032.218
BH15A	5581.081	5027.513
BH16	5577.030	5040.875
BH16A	5571.972	5031.738
BH17	5547.380	5047.918
BH18	5549.903	5033.564
BH19	5527.912	5028.782
BH20	5516.558	5018.116

Water Monitoring Locations

Water Sample I.D.'s	Easting	Northing
SW1	5041.936	5388.239
SW2	4963.347	5304.715
SW3	4996.475	5055.871
SW4	5007.627	5060.869
SW5	5214.581	5041.517
SW6	5630.914	5331.117
SW7	5540.404	5191.359
SW8	5457.929	5022.281
SW9	5063.947	4707.944
SW10	4730.794	4396.464
BH1/88	4984.649	5292.405
BH2/88	5018.043	5071.678
BH22	5450.473	5046.615
BH96B	5118.544	4875.527
L1	5050.756	5296.104
L4	5080.621	5071.335
L5	5285.330	5049.782
L6	5370.160	5025.942
L7	5457.527	5079.782

REV	MODIFICATIONS	BY	CH	AP	DATE
B	General amendments	GR	AC	AC	04.02.22
A	Monitoring plan amended	JB	AC	AC	22.06.21

CYNGOR SIR YNYS MÔN ISLE OF ANGLESEY COUNTY COUNCIL

Penhesgyn Landfill Site

Monitoring Locations

DRAWN BY	CHECKED BY	APPROVED BY
DMD	GOJR	IR
DATE	SCALE @ A1	REVISION
07.01.2015	1:1250	B

ISSUE: Information

DRAWING NUMBER: 5379.SURV.D03

ENGINEERING ENVIRONMENTAL HEALTH & SAFETY — egniol

www.egniol.com

© COPYRIGHT EGNIOL ENVIRONMENTAL LIMITED - NOT TO BE COPIED OR REPRODUCED IN ANY WAY OR FORM WITHOUT PRIOR WRITTEN CONSENT FROM EGNIOL ENVIRONMENTAL LIMITED

CAD FILE REF: M:\CAD Projects\5379 Penhesgyn Landfill Site\5379\Drawings\Current Working Drawings\5379.SURV.D03.B.dwg