
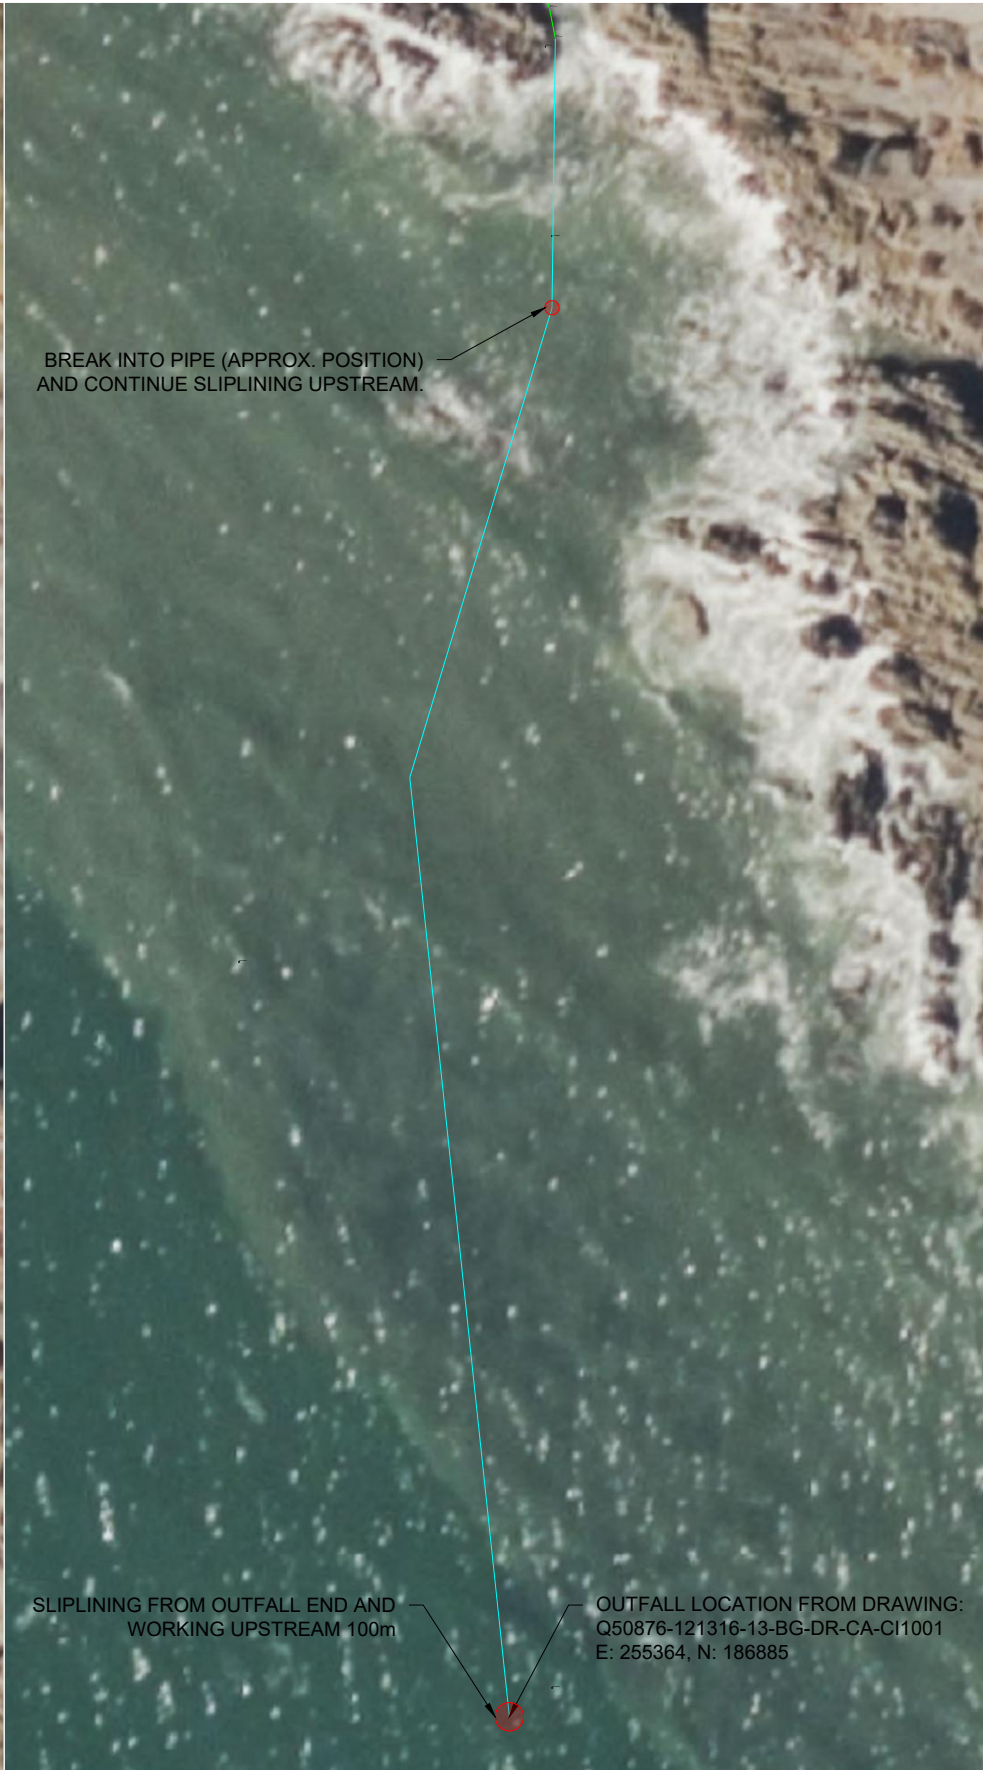
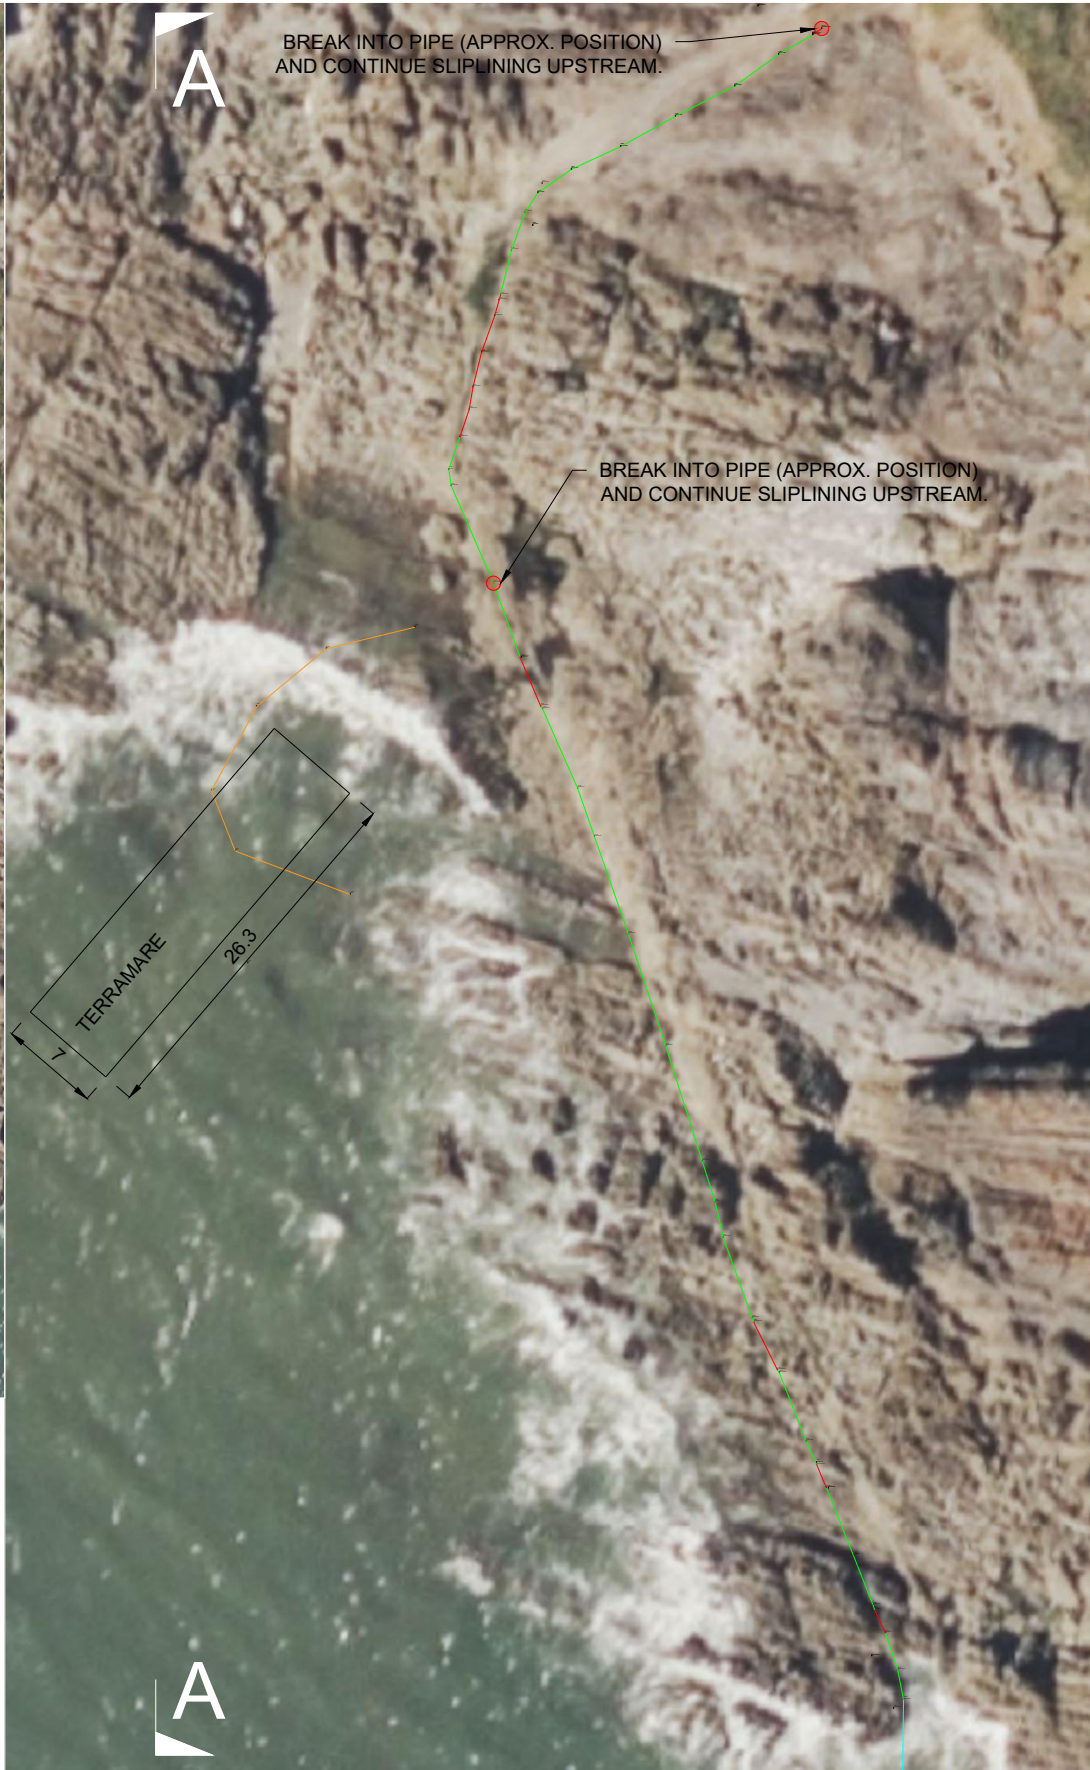
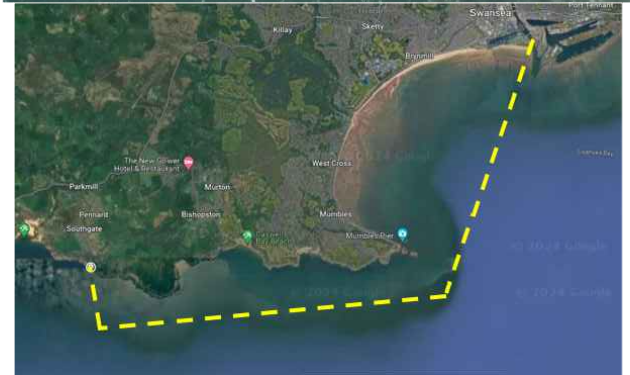


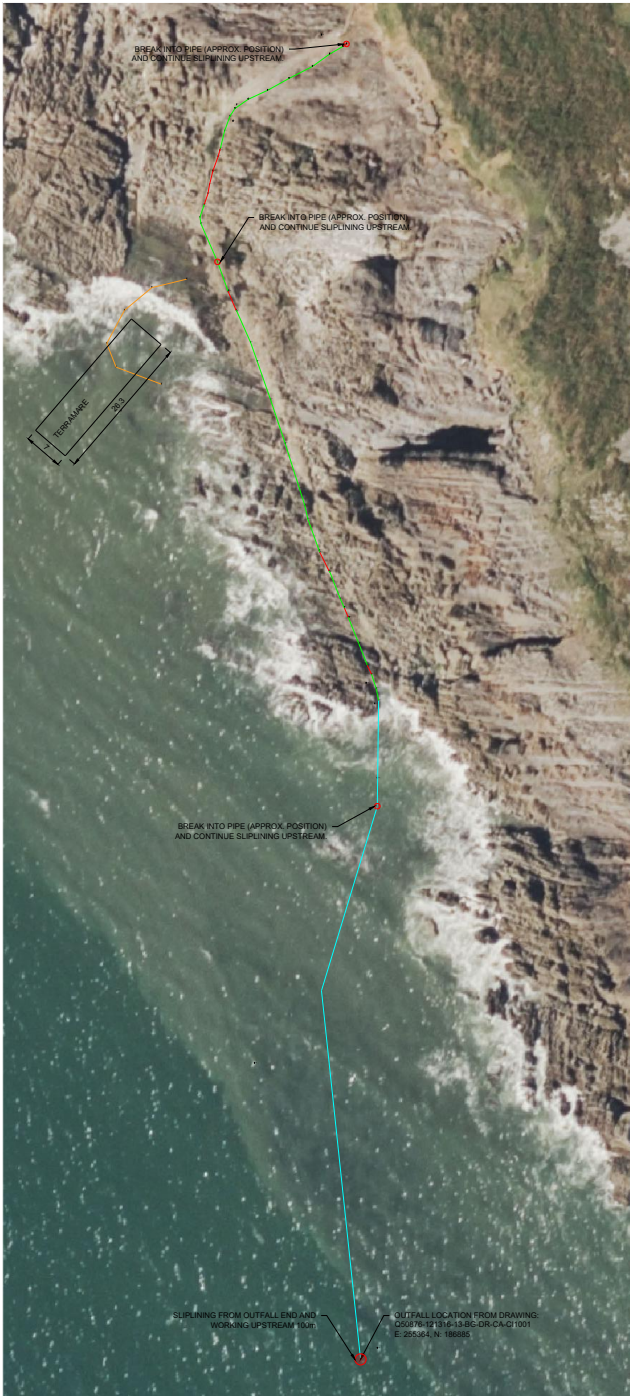

NOTES:

DO NOT SCALE FROM THIS DRAWING.

THIS DRAWING IS FOR INFORMATION ONLY.

GREEN LINES ARE APPROX LINE OF PIPE SURVEYED BY KAYMAC ENGINEER. NOT THIS IS APPROXIMATE AS PIPELINE IS BURIED, AND SO CORRESPONDING LEVELS ARE AT SURFACE LEVEL AND NOT CROWN LEVEL.

RED LINES ARE EXPOSED AREAS OF PIPE, MEASURED ALONG CROWN OF PIPE.

BLUE LINES ARE PIPE COORDINATES FROM DRAWING Q50876-121316-13-BG-DR-CA-C11001.

BEACHED LOCATION OF TERRAMARE LANDING CRAFT VESSEL IS SHOWN INDICATIVELY, AND BEACHED POSITION WILL VARY BASED ON STATE OF TIDE DURING WORKS, AND PROGRESS OF WORKS.

LEVELS AND DISTANCES TO BE VERIFIED ONSITE DURING WORKS, WITH ANY SIGNIFICANT DEVIATIONS TO BE REFERRED BACK TO KAYMAC ENGINEER FOR COMMENT.

| REV                                | DATE | BY | REV DESCRIPTION |
|------------------------------------|------|----|-----------------|
| DRAWING STATUS:<br>FOR INFORMATION |      |    |                 |

CLIENT:



PROJECT REF:  
SOUTHGATE PIPE REPAIR

DRAWING TITLE:  
SOUTHGATE PIPE LAYOUT AND CROSS SECTION

DRAWING NUMBER:  
KM/DCWW/SOUTHGATE/PIPELAYOUT

ISSUE DATE:  
03/09/2024

SCALE:  
NTS

  
Marine & Civil Engineering Ltd

Head Office & Accounts  
Osprey Business Park  
Byng Street, Landore,  
Swansea, SA1 2NR  
Tel: (01792) 301818  
Fax: (01792) 645698

Bristol Office  
St. Andrews House  
St. Andrews Road  
Avonmouth  
Bristol BS11 9DQ  
Tel: (01179) 382603

Email: [enquiries@kaymacld.co.uk](mailto:enquiries@kaymacld.co.uk)  
Website: [www.kaymacmarine.co.uk](http://www.kaymacmarine.co.uk)

