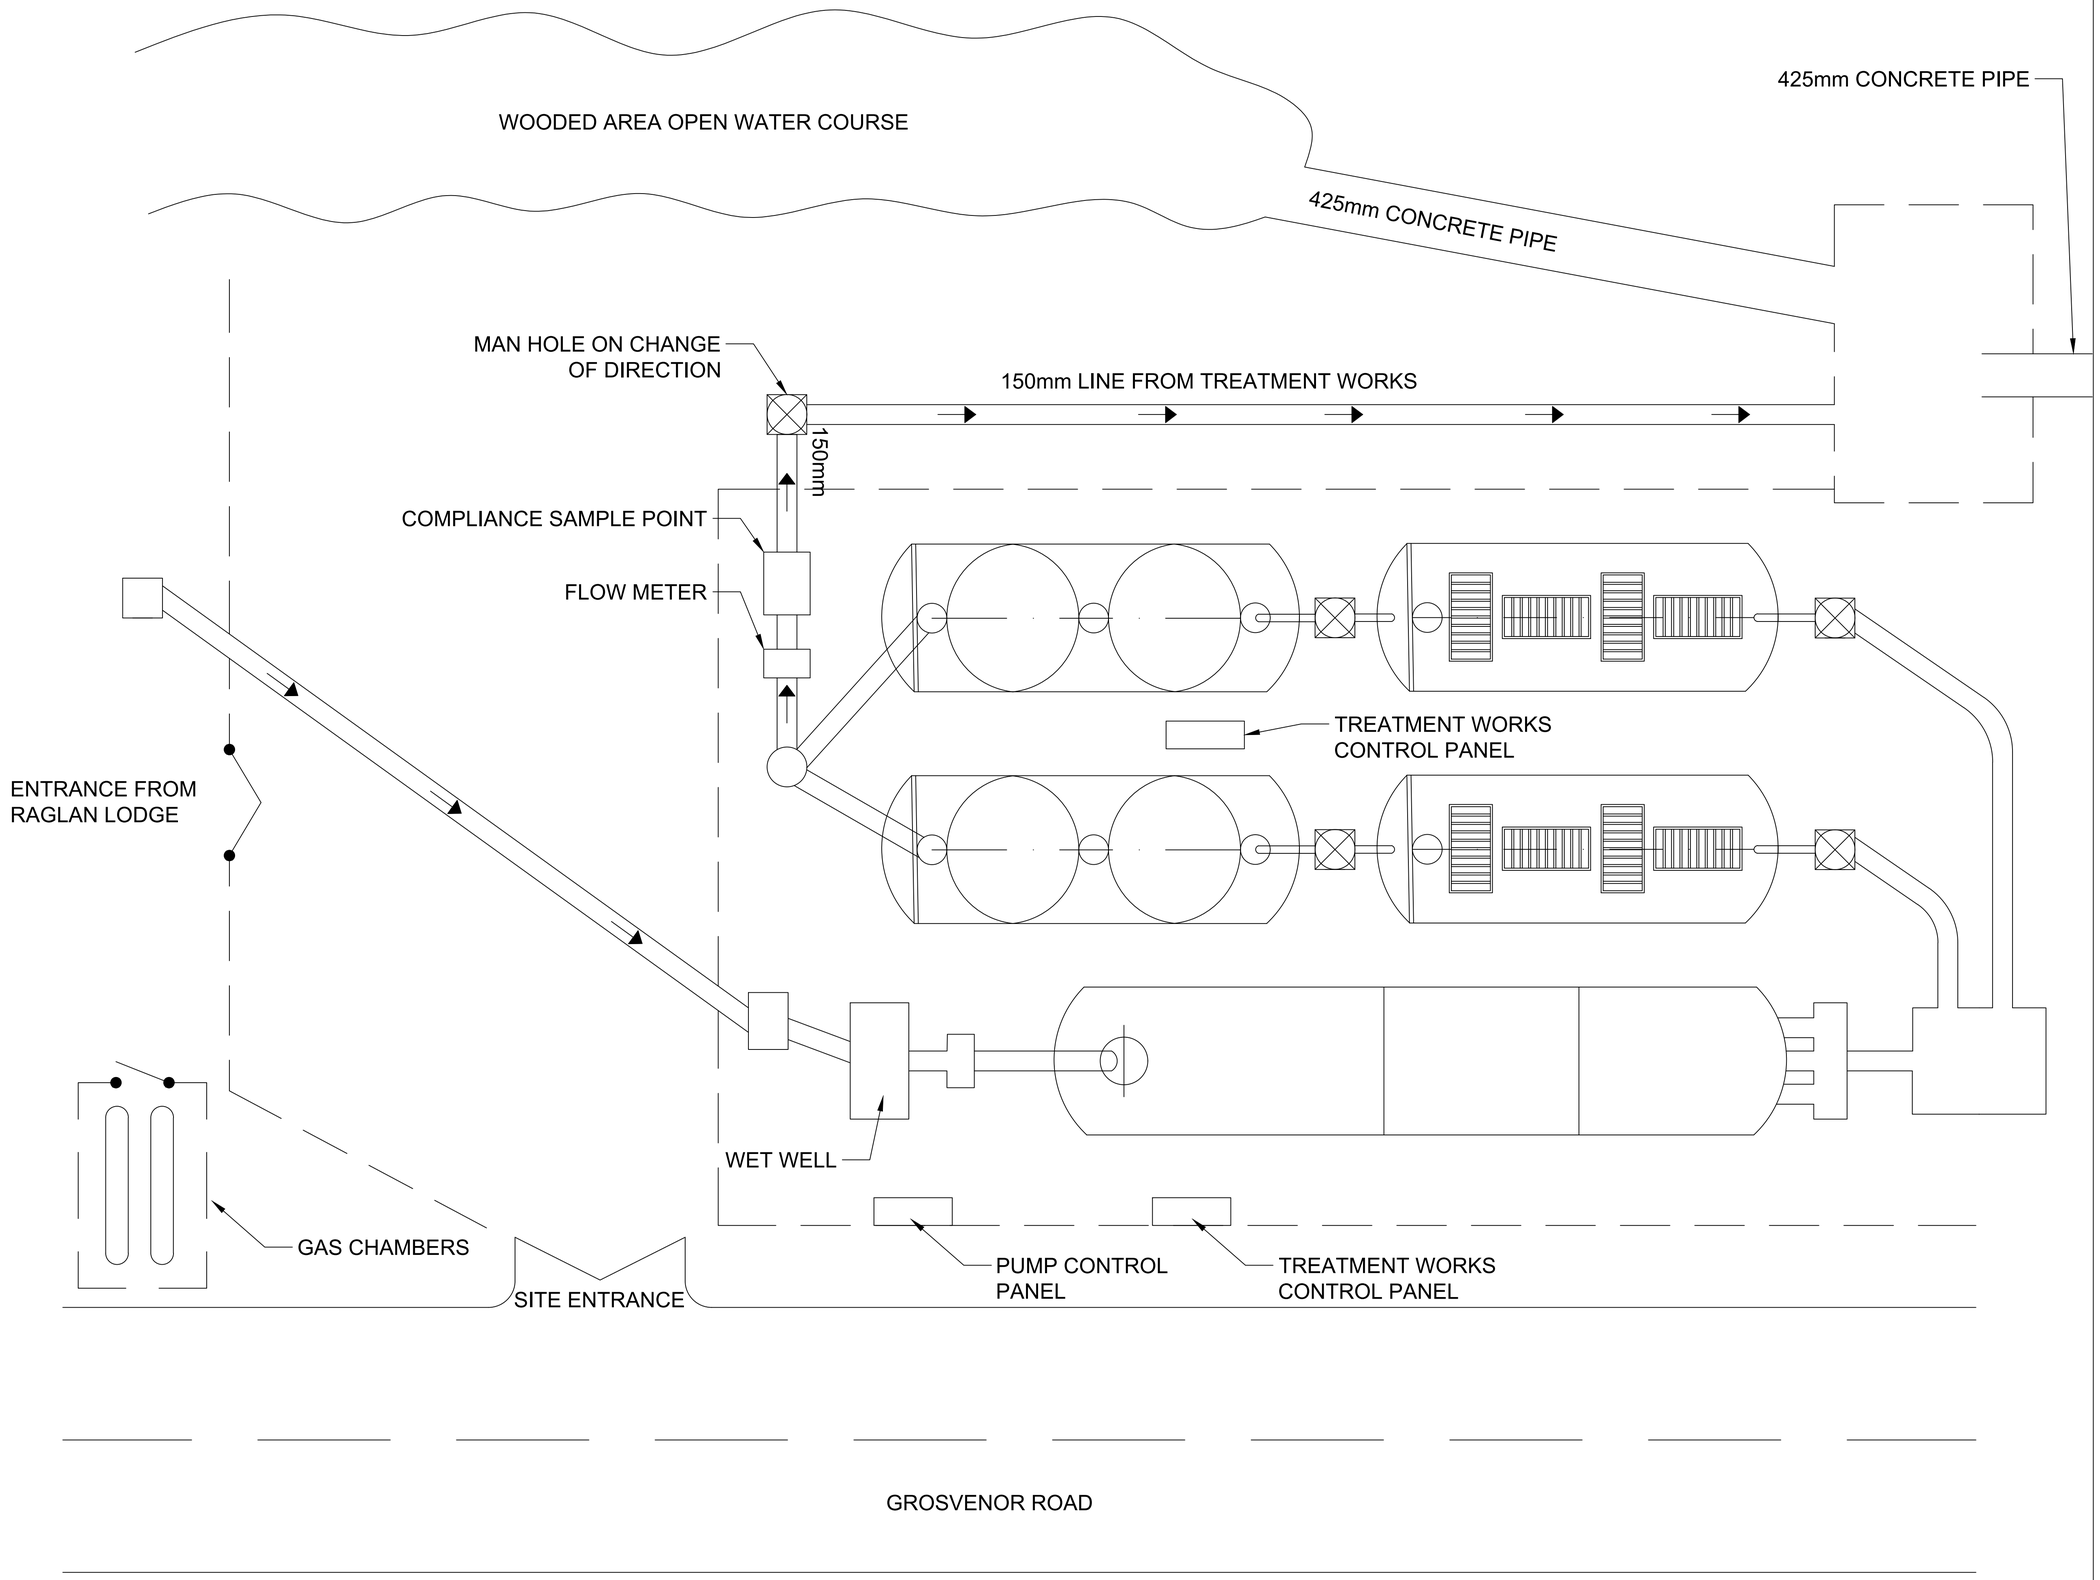

NOTES:
1. ALL DIMENSIONS IN MILLIMETERS UNLESS SHOWN OTHERWISE.
2. THIS DRAWING IS ISSUED FOR REFERENCE PURPOSE ONLY.

Rev	Date	Description	Prod.	Chk.	Rev.
P03	17/08/26	For Review and Comment	JD	MA	IL
P02	08/05/26	As-Built Update	JD	MA	IL
P01	13/02/26	First Issue	JD	MA	IL

PURE UTILITY SOLUTIONS LTD
701 CLOCK FACE ROAD, BOLD HEATH,
WIDNES, MERSEYSIDE,
WA8 3XX
TEL: 01744816660

Drawing Title:

MONMOUTH SERVICE STATION

SHEET 1 OF 1

Scale: NTS

Sheet size: A1

Drawing Number: 01

Revision: P03